
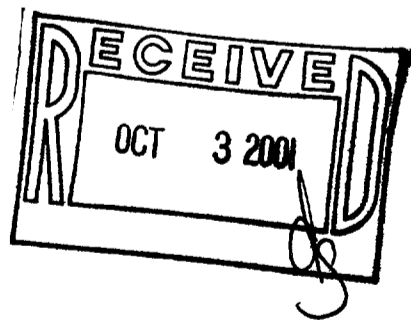


# PLAT OF SURVEY

OF

Lot 12, Block 14 of LAKE GENEVA MANOR, Tract No. 17, being a subdivision located in the East Half of Section 35, Town 2 North, Range 17 East of the 4th Principal Meridian, City of Lake Geneva, Walworth County, Wisconsin.

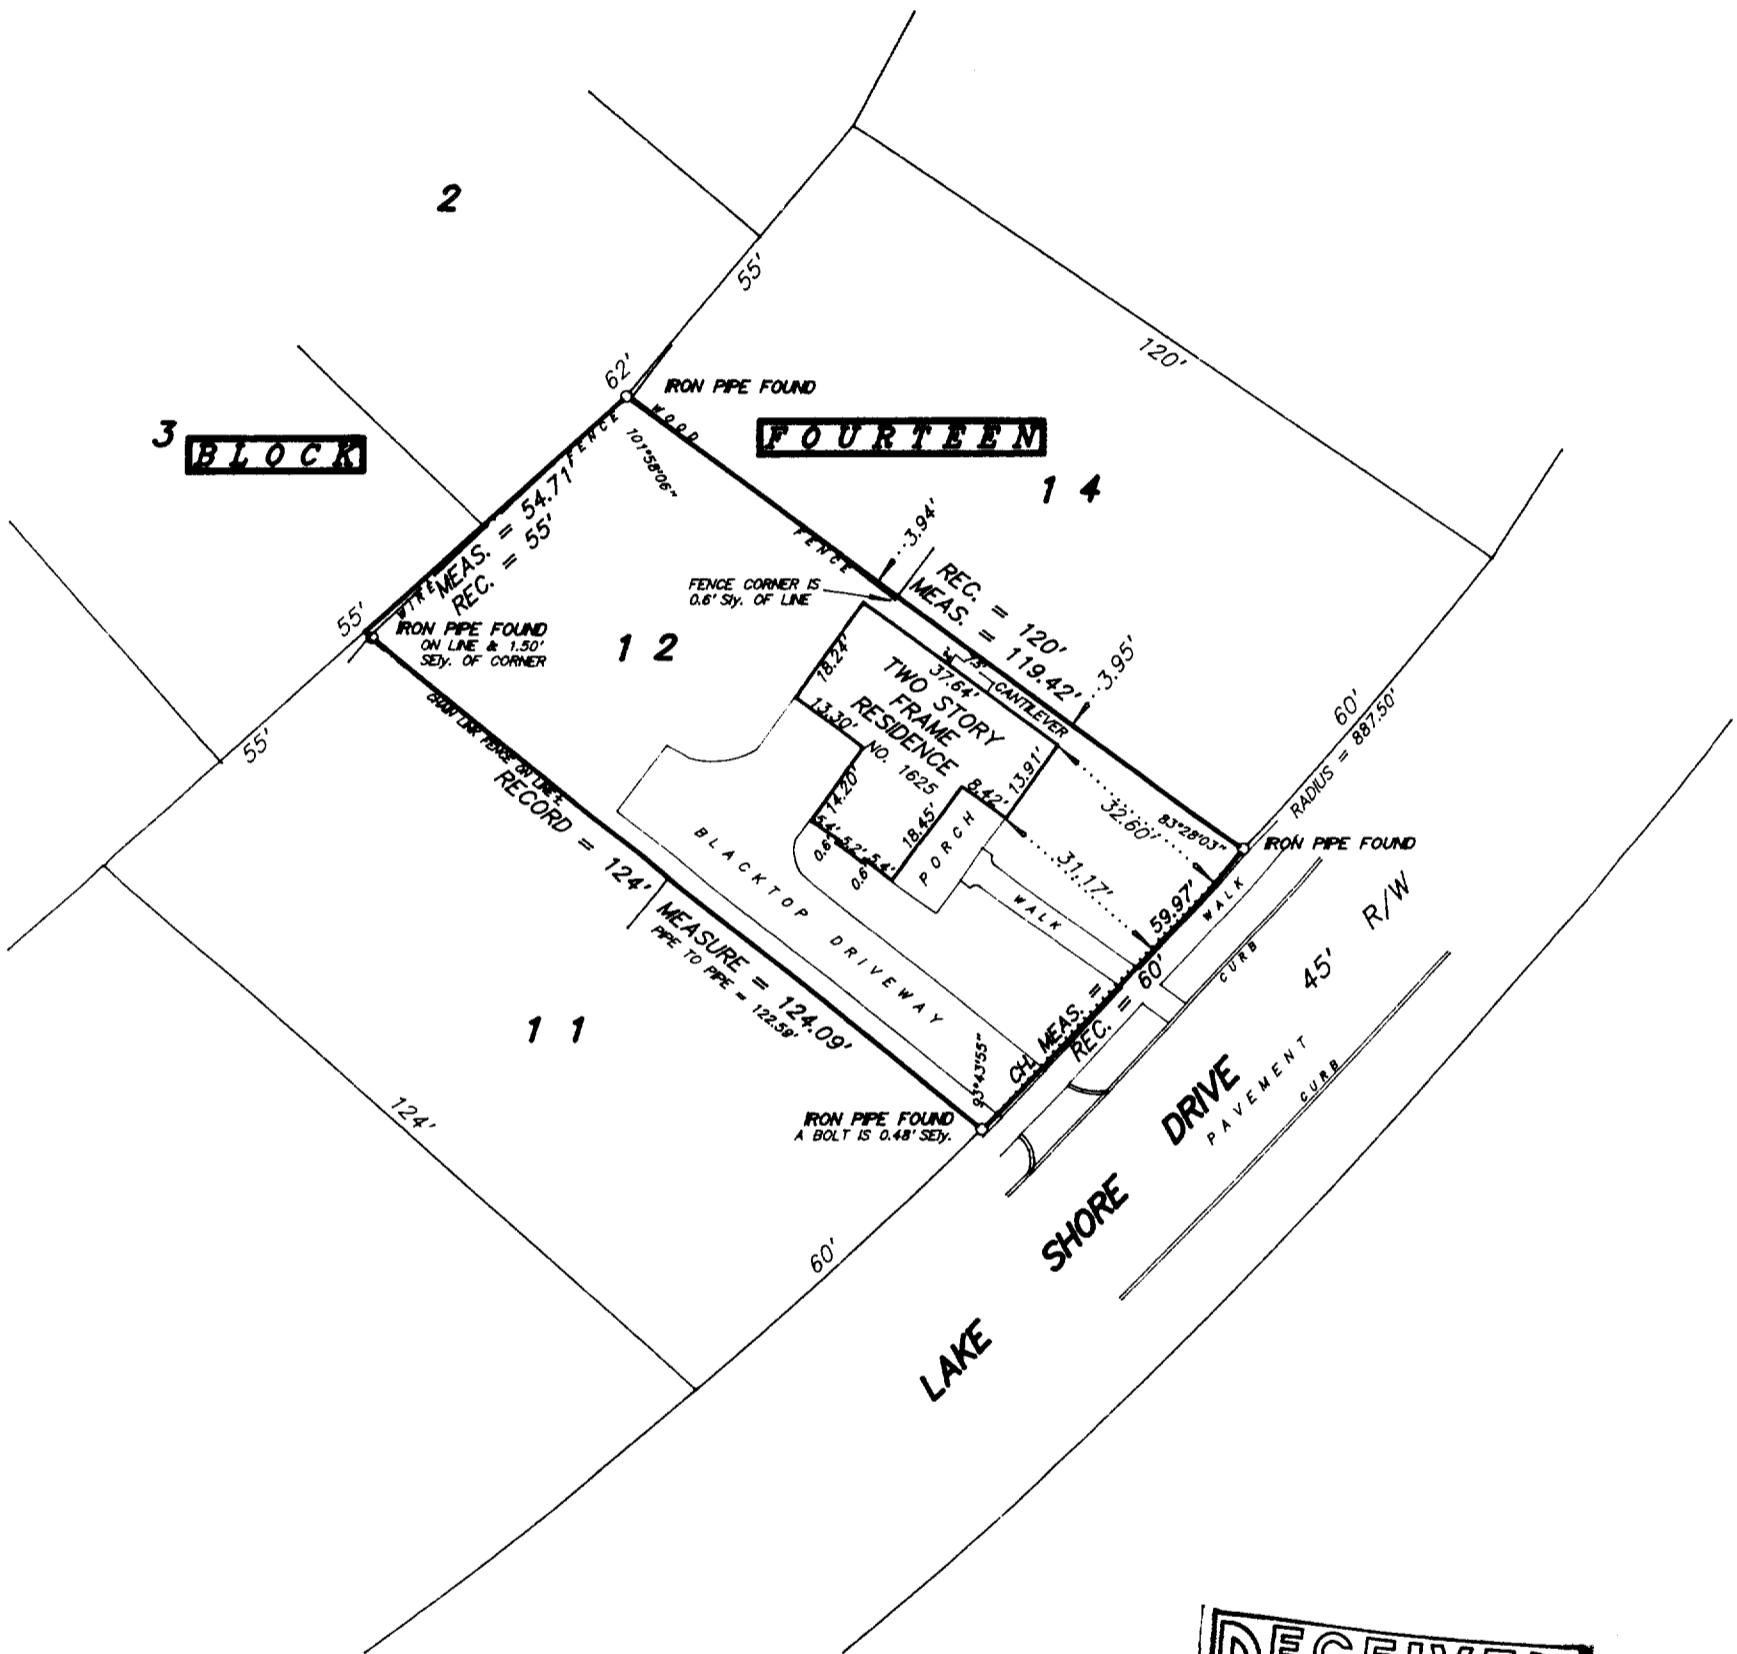

SCALE 1 inch = 30 feet  
ORDERED BY C. Bowman  
JOB NO. 01048

I hereby certify that I have surveyed the above described property and the above plat is a true representation thereof and shows the size and location of the property, its exterior boundaries, the location and dimensions of all visible structures thereon, boundary fences, apparent easements and roadways and visible encroachments, if any.

This survey is made for the exclusive use of the present owners of the property, and also those who purchase, mortgage, or guarantee the title thereto within one year from the date hereof.

Dated at Bassett, Wisconsin this \_\_\_\_\_ day of \_\_\_\_\_ 2001.

Mark A. Bolender  
Wisconsin Registered Land Surveyor S - 1784

ZLM-22  
7-1985