


ST.

EAST

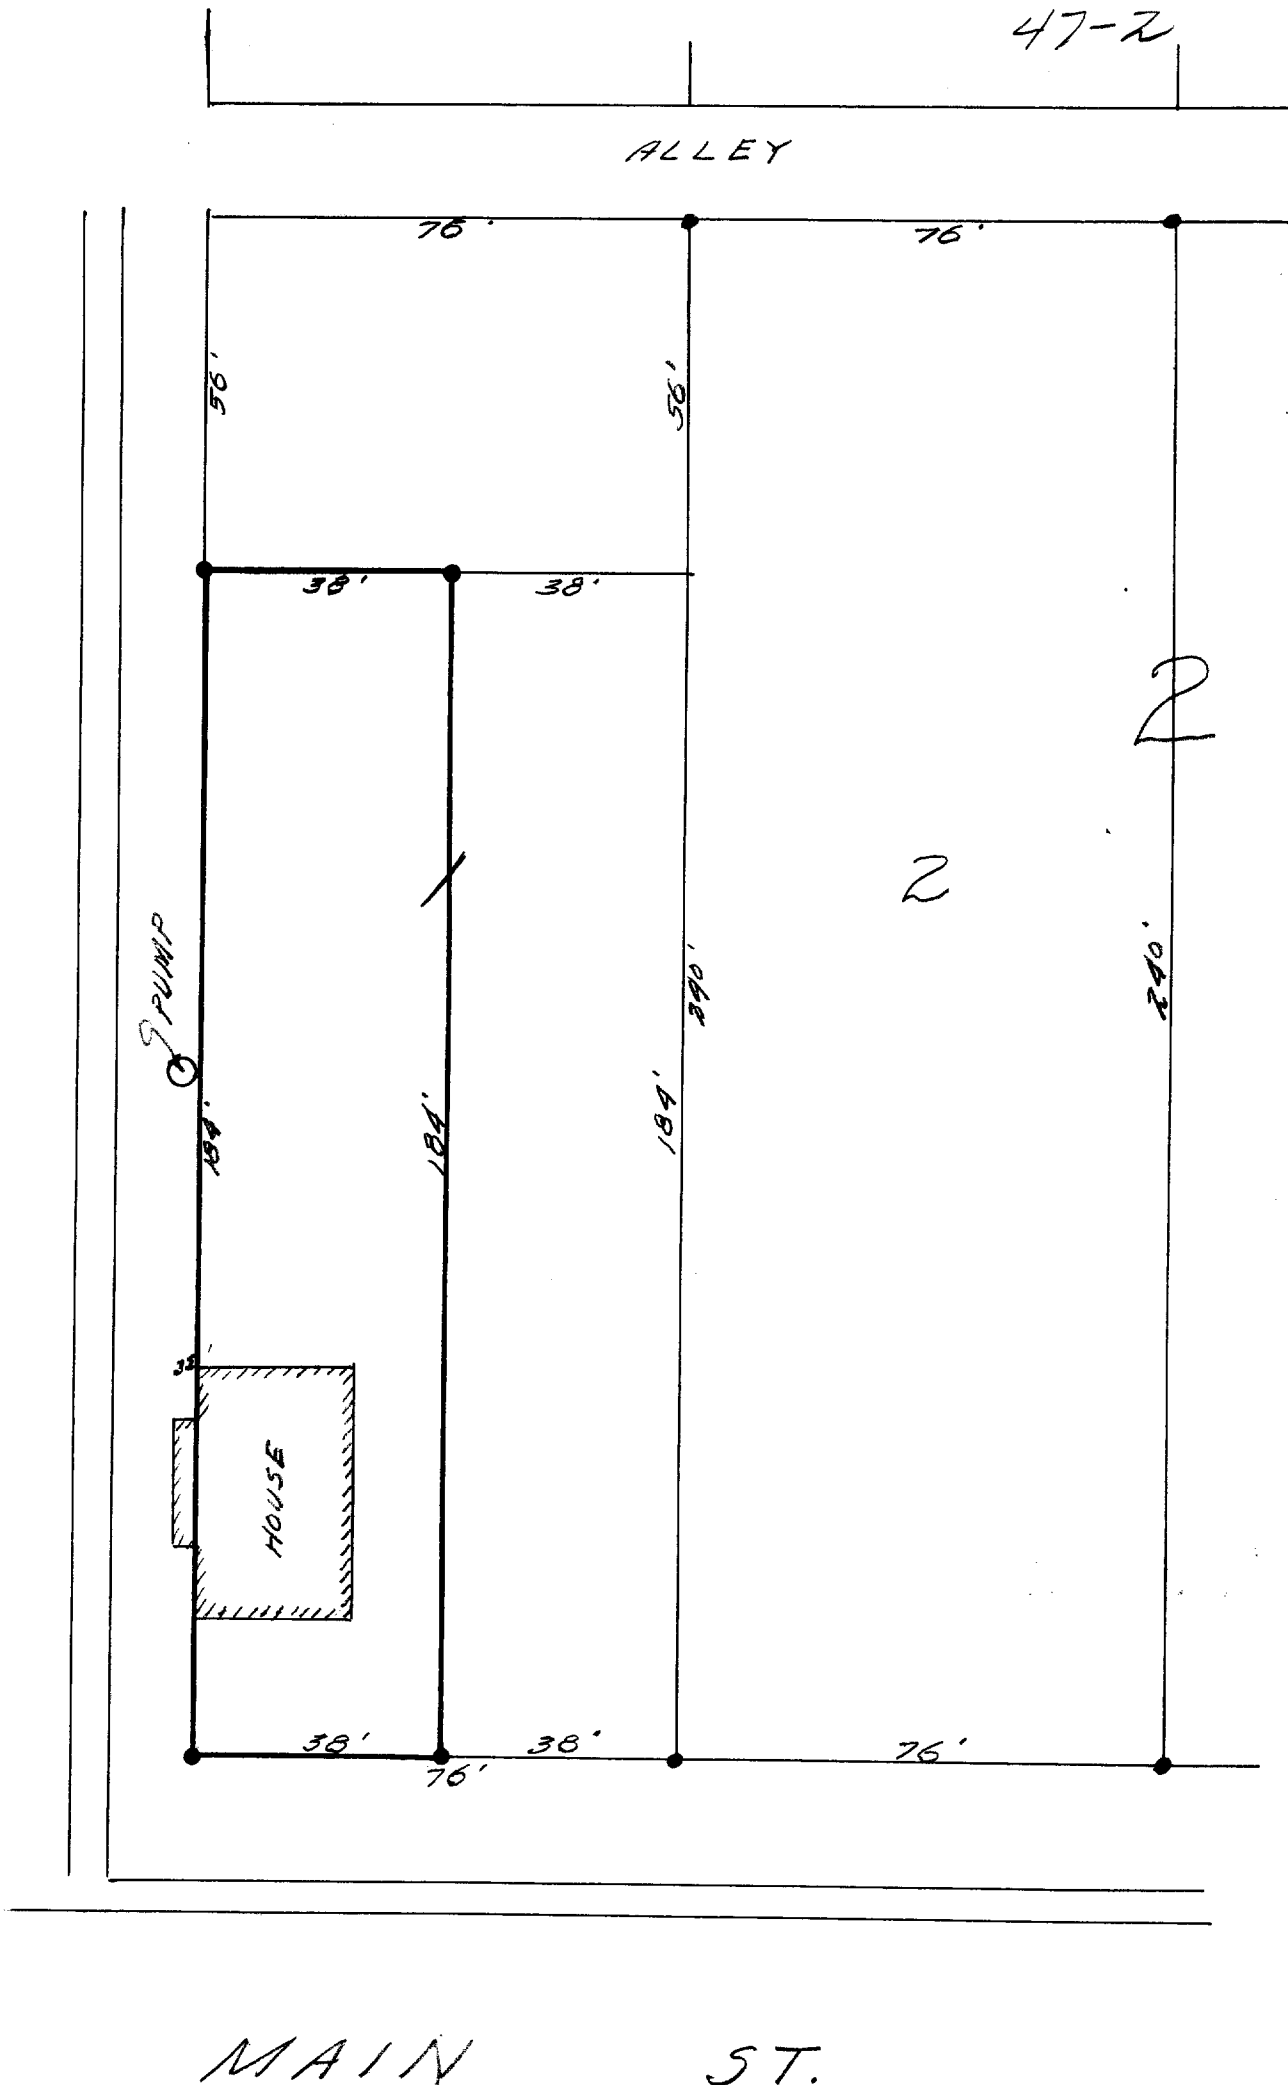

MAIN

ST.

DESCRIPTION:

The north 184 feet of the east  $\frac{1}{2}$  of Lot 1, Block 2, E.D. Phillip's Subdivision, of the City of Lake Geneva Walworth County, Wisconsin.

CERTIFICATE:

I, hereby certify that I have on this the 8th day of April, 1947; surveyed the above described property according to the official records on file in the office of the Recorder of Deeds in and for Walworth County, Wisconsin, and find that the measurements and bearings of the boundary lines of said property as taken at the site on this day, substantially agree with those on the above portrayed plat, and that two encroachments exist on East Street, the pump encroaches the street 3 feet and the eaves encroach upon the street  $3\frac{1}{2}$  feet.

SIGNED AND SEALED THIS 8TH DAY OF APRIL 1947.

*Joseph M. Biagi*  
Joseph M. Biagi Professional Engineer  
Elkhorn Wisconsin.