
ABELLSURVEYING & MAPPING

1140 SEQUOIA STREET . DELAVAN, WISCONSIN 53115 262-728-6737

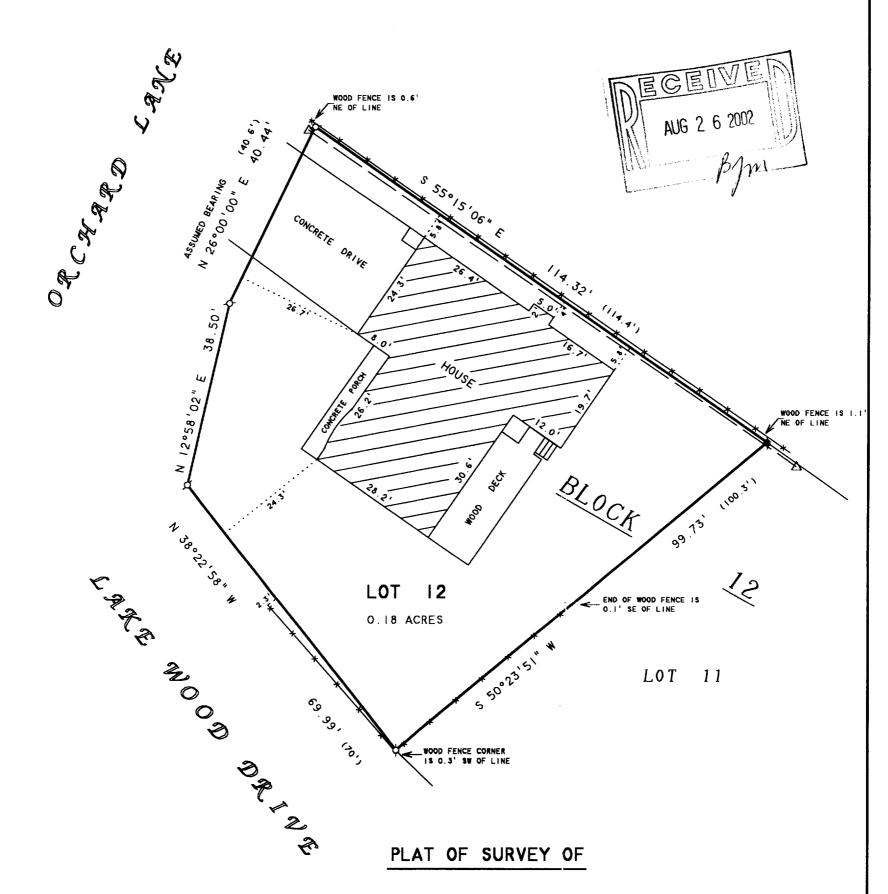

LOT 12. BLOCK 12 OF LAKE GENEVA MANOR. LOCATED IN THE CITY OF LAKE GENEVA. WALWORTH COUNTY. WISCONSIN.

ORDERED BY: BOB STELLE 1610 ORCHARD LANE LAKE GENEVA. WI 53147





SCALE | " = 20 '

LEGEND

 ${\mathcal O}$ - IRON PIPE FOUND **■** - IRON ROD FOUND A- UTILITY POLE - OVERHEAD UTILITY LINES *-- WOOD FENCE ()- RECORDED AS

I HEREBY CERTIFY THAT I HAVE SURVEYED THE ABOVE DESCRIBED PROPERTY AND THAT THE THEREBY CERTIFY THAT I HAVE SURVEYED THE ABOVE DESCRIBED PROPERTY AND THAT IF ABOVE MAP IS A TRUE REPRESENTATION THEREOF AND SHOWS THE SIZE AND LOCATION OF THE PROPERTY. ITS EXTERIOR BOUNDARIES. THE LOCATION OF ALL VISIBLE STRUCTURES AND DIMENSIONS OF ALL PRINCIPAL BUILDINGS THEREON. BOUNDARY FENCES. APPARENT EASEMENTS. ROADWAYS AND VISIBLE ENCROACHMENTS. IF ANY. TO THE BEST OF MY KNOWLEDGE AND BELIEF

THIS SURVEY IS MADE FOR THE USE OF THE PRESENT OWNERS OF THE PROPERTY, AND ALSO THOSE WHO PURCHASE, MORTGAGE, OR GUARANTEE THE TITLE THERETO WITHIN ONE (I) YEAR FROM DATE HEREON.

DAVID F. ABELL WISCONSIN REGISTERED LAND SURVEYOR. S-1596

July 30, 200 Z
DATE NOTE: THIS IS NOT A CERTIFIED

JOB NUMBER - 02110 THIS IS NOT A CERTIFIED COPY UNLESS SEALED.