

# FARRIS, HANSEN & ASSOCIATES, INC.




ENGINEERING - ARCHITECTURE - SURVEYING  
 7 RIDGWAY COURT - P.O. BOX 437 - ELKHORN, WISCONSIN 53121  
 PHONE: (262) 723-2098 FAX: (262) 723-5886

## PLAT OF SURVEY

### LOT 25 OF EDGEWOOD HILLS, A SUBDIVISION

LOCATED IN THE SW 1/4 AND THE SE 1/4 OF THE NE 1/4  
 & NE 1/4 AND THE NW 1/4 OF THE SE 1/4 OF SECTION 26,  
 TOWN 2 NORTH, RANGE 17 EAST, TOWN OF GENEVA AND  
 CITY OF LAKE GENEVA, WALWORTH COUNTY, WISCONSIN


- WORK ORDERED BY -  
 JORNDT BUILDERS  
 1809 SOUTH SHORE DRIVE  
 DELAVAN, WI. 53115

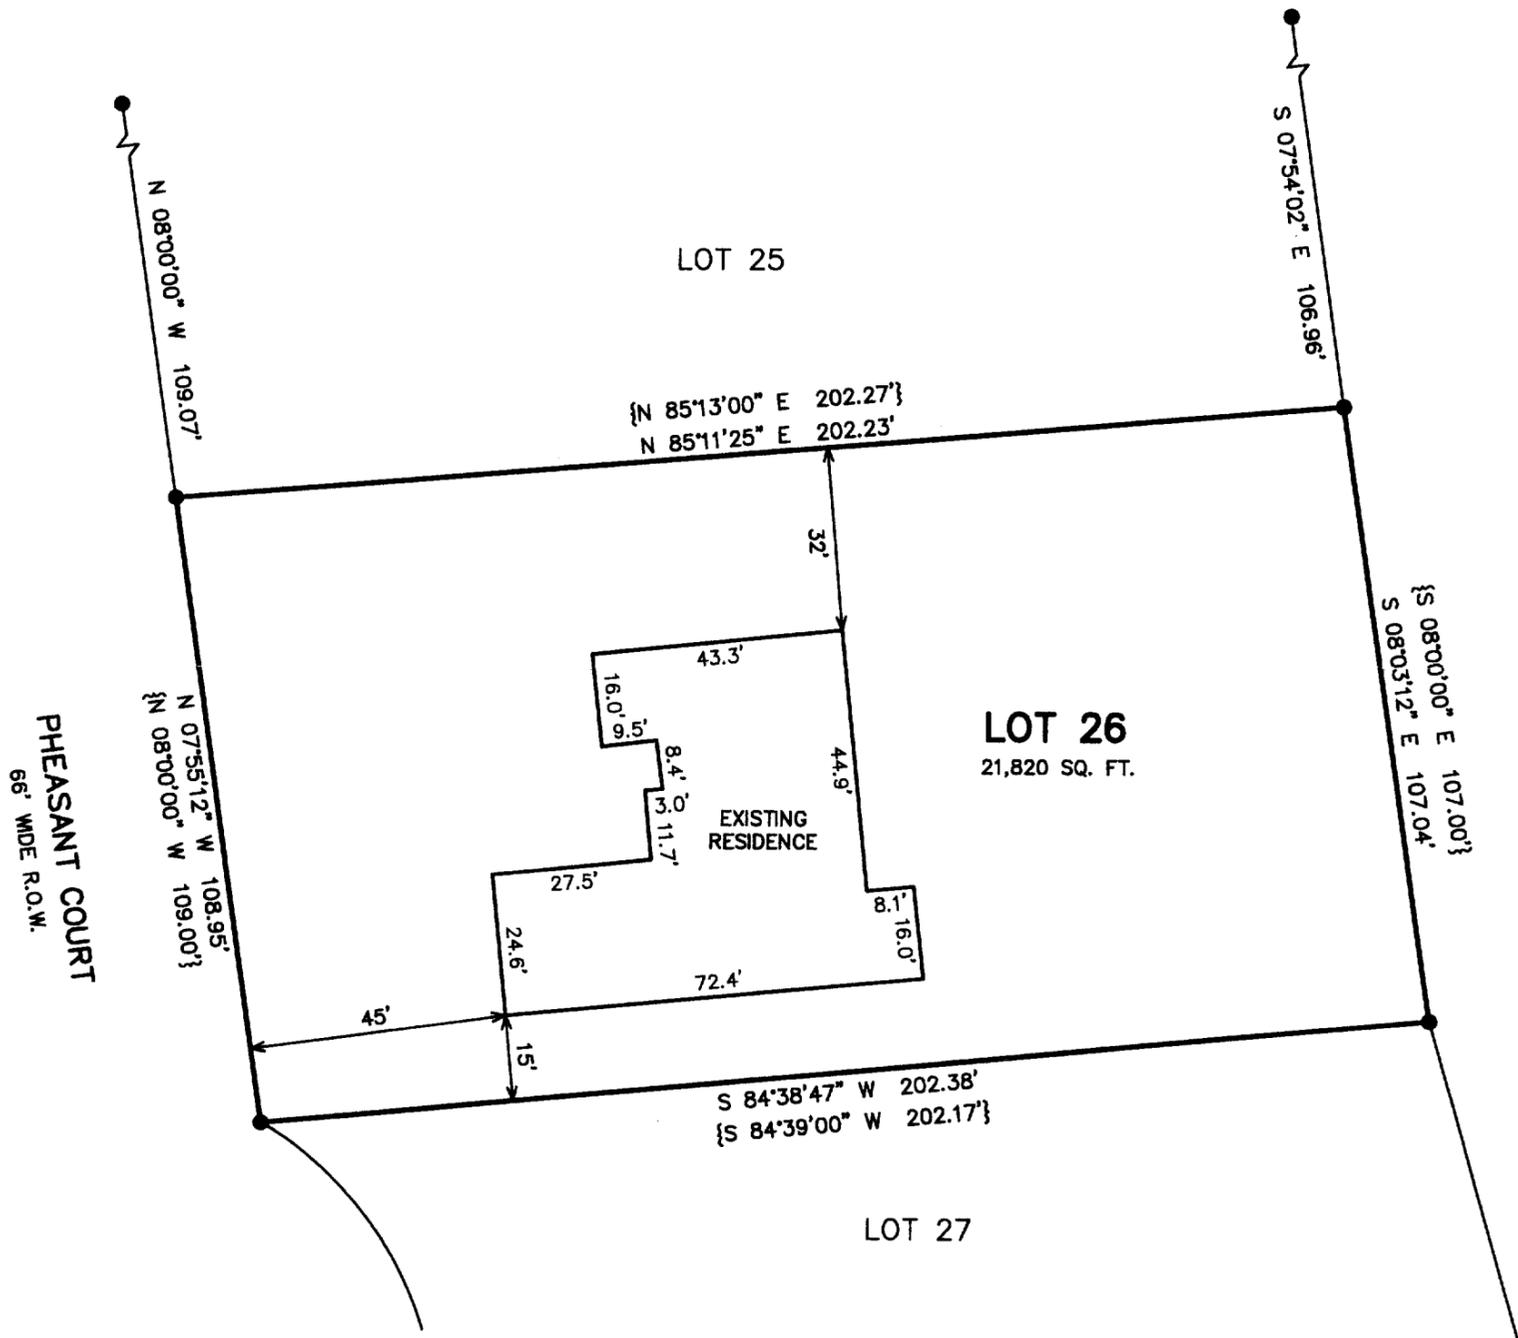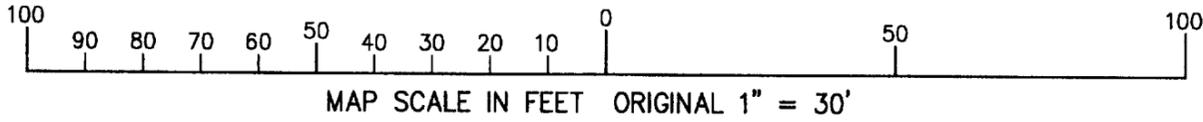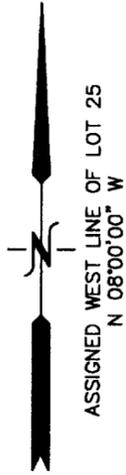

PHEASANT COURT  
 66' WIDE R.O.W.

#### LEGEND

- = FOUND IRON REBAR STAKE
- {XXX} = RECORDED AS

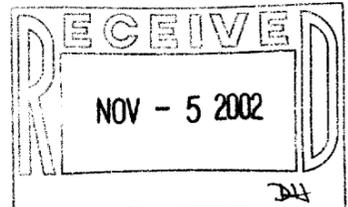

NOTE: COPIES OF THIS MAP TO WHICH THE FOLLOWING CERTIFICATE WILL APPLY SHOW THE SURVEYOR'S ORIGINAL SEAL AND SIGNATURE IN RED INK. COPIES BY ANY OTHER MEANS MAY HAVE ALTERATIONS WHICH DO NOT REPRESENT THE SURVEYOR'S WORK PRODUCT.

I HEREBY CERTIFY THAT THE ABOVE DESCRIBED PROPERTY HAS BEEN SURVEYED UNDER MY DIRECTION AND THAT THE ABOVE MAP IS A TRUE REPRESENTATION THEREOF AND SHOWS THE SIZE AND LOCATION OF THE PROPERTY AND ITS EXTERIOR BOUNDARIES. THIS SURVEY IS MADE FOR THE USE OF THE PRESENT OWNERS OF THE PROPERTY, AND ALSO THOSE WHO PURCHASE, MORTGAGE, OR GUARANTEE THE TITLE THERETO WITHIN ONE YEAR FROM THE DATE HEREOF.

DATED: OCT. 30, 2002

*Peter S. Gordon*  
 PETER S. GORDON R.L.S. 2101

PROJECT: 6145  
 DATE: 10/30/2002  
 SHEET 1 OF 1

X:\PROJECTS\6145\DCAD\SURVEY.DCS 10/30/2002

ZEM -25  
 26  
 007-2049