PREPARED FOR: MIKE SHOSIE PO. BOX 479 POWERS LAKE


WI. 53159

PLAT OF SURVEY

J.K. SURVEYING INC. N3705 WILLOWBEND LANE LAKE GENEVA, WI. 53147 262-248-3697

- OF -

LOT 68, COLUMBIAN SUBDIVISION CITY OF LAKE GENEVA, WALWORTH COUNTY, WISCONSIN

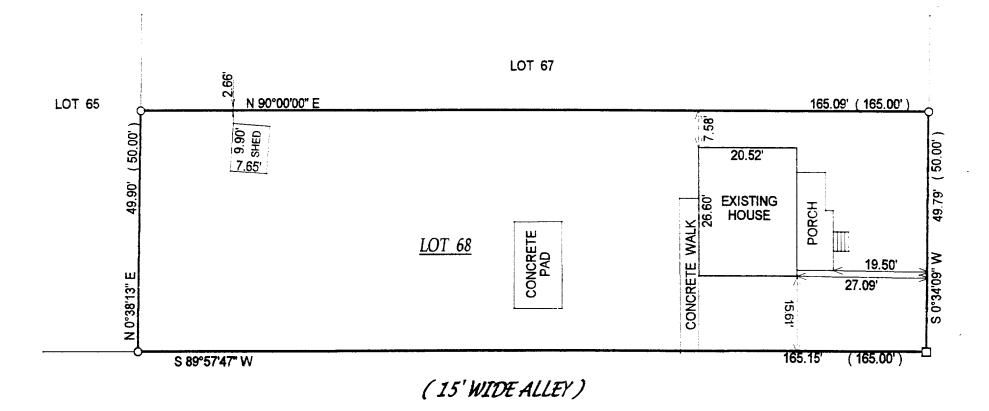



()= recorded as

= found iron bar

= found iron pipe

= set iron pipe

= set iron bar

SCALE 1" = 20'

JOB #02-612


TAX ID # ZCL00058


NOTE: BEARINGS ARE ASSUMED.

COMPARE LEGAL DESCRIPTION ABOVE AND DRAWING WITH DEED. FOR BUILDING RESTRICTIONS AND EASEMENTS NOT SHOWN, REFER TO DEED, ABSTRACT SOURCES AND LOCAL MUNICIPAL CODES. NOTIFY THE SURVEYOR IMMEDIATELY OF ANY DISCREPANCY.

"I hereby certify that I have surveyed the above described property and that the above map is a true representation thereof and shows the size and location of all visible structures, apparent easements and encroachments if any."

This survey is made for the present owners of the property, and those who purchase, mortgage, or guarantee the title thereto, within one year from the date hereof.

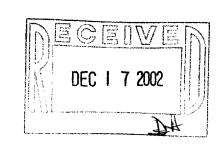

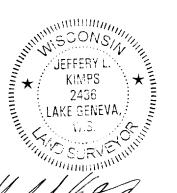

Wisconsin Registered Land Surveyor (original if signed in red)

DATED THIS THE 26th DAY OF NOVEMBER 2002.