
PLAT OF SURVEY -OF-

LOT 3, BLOCK 18 OF LAKE GENEVA MANOR, LOCATED IN THE CITY OF LAKE GENEVA, WALWORTH COUNTY, WISCONSIN.

SURVEY FOR: REMAX GENEVA REALTY SURVEY ADDRESS: 1620 LAKESHORE DRIVE

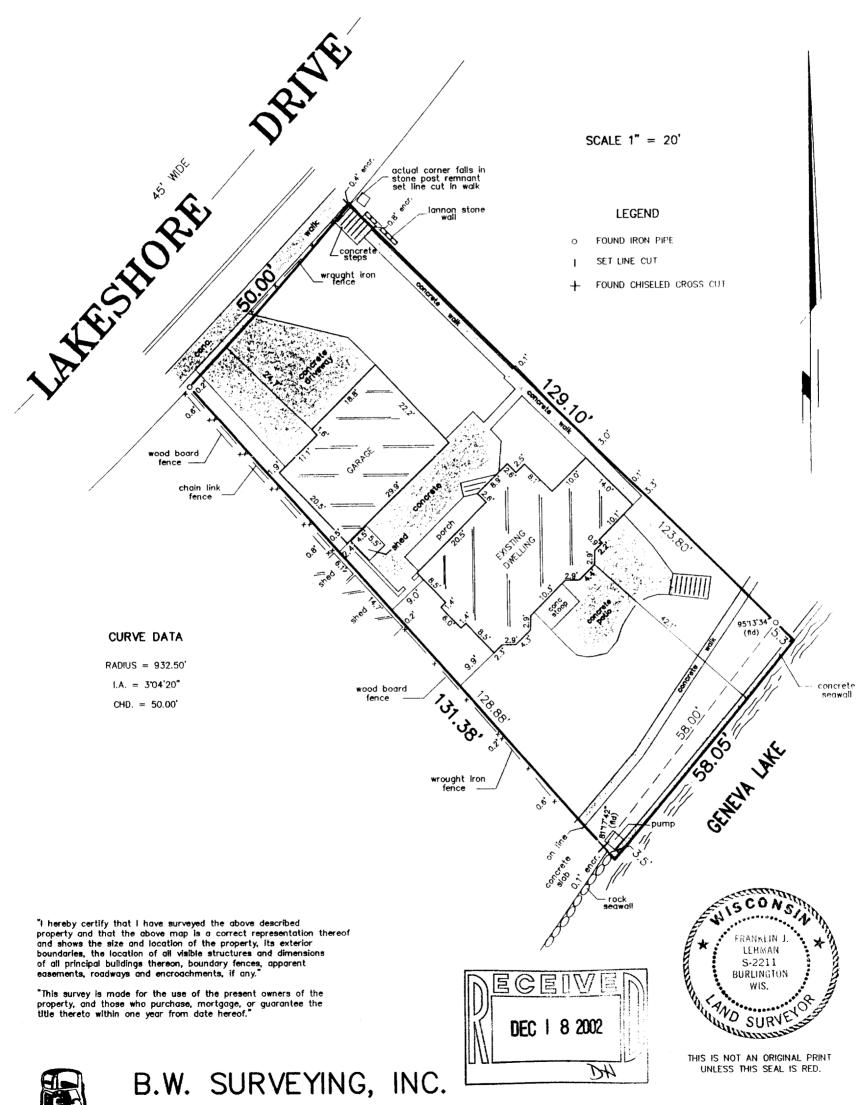

LAND SURVEYS
MAPPING AND PLANNING
412 N. PINE STREET
BURLINGTON, WI 53105
(262)-767-0225

Franklin J. LEHMAN S-221

SEPT. 27, 2002 DATE

JOB NUMBER