


PLAT OF SURVEY

A PARCEL OF LAND LOCATED IN THE NORTHEAST 1/4 OF SECTION 35, TOWN 2 NORTH, RANGE 17 EAST, CITY OF LAKE GENEVA, WALWORTH COUNTY, WISCONSIN.

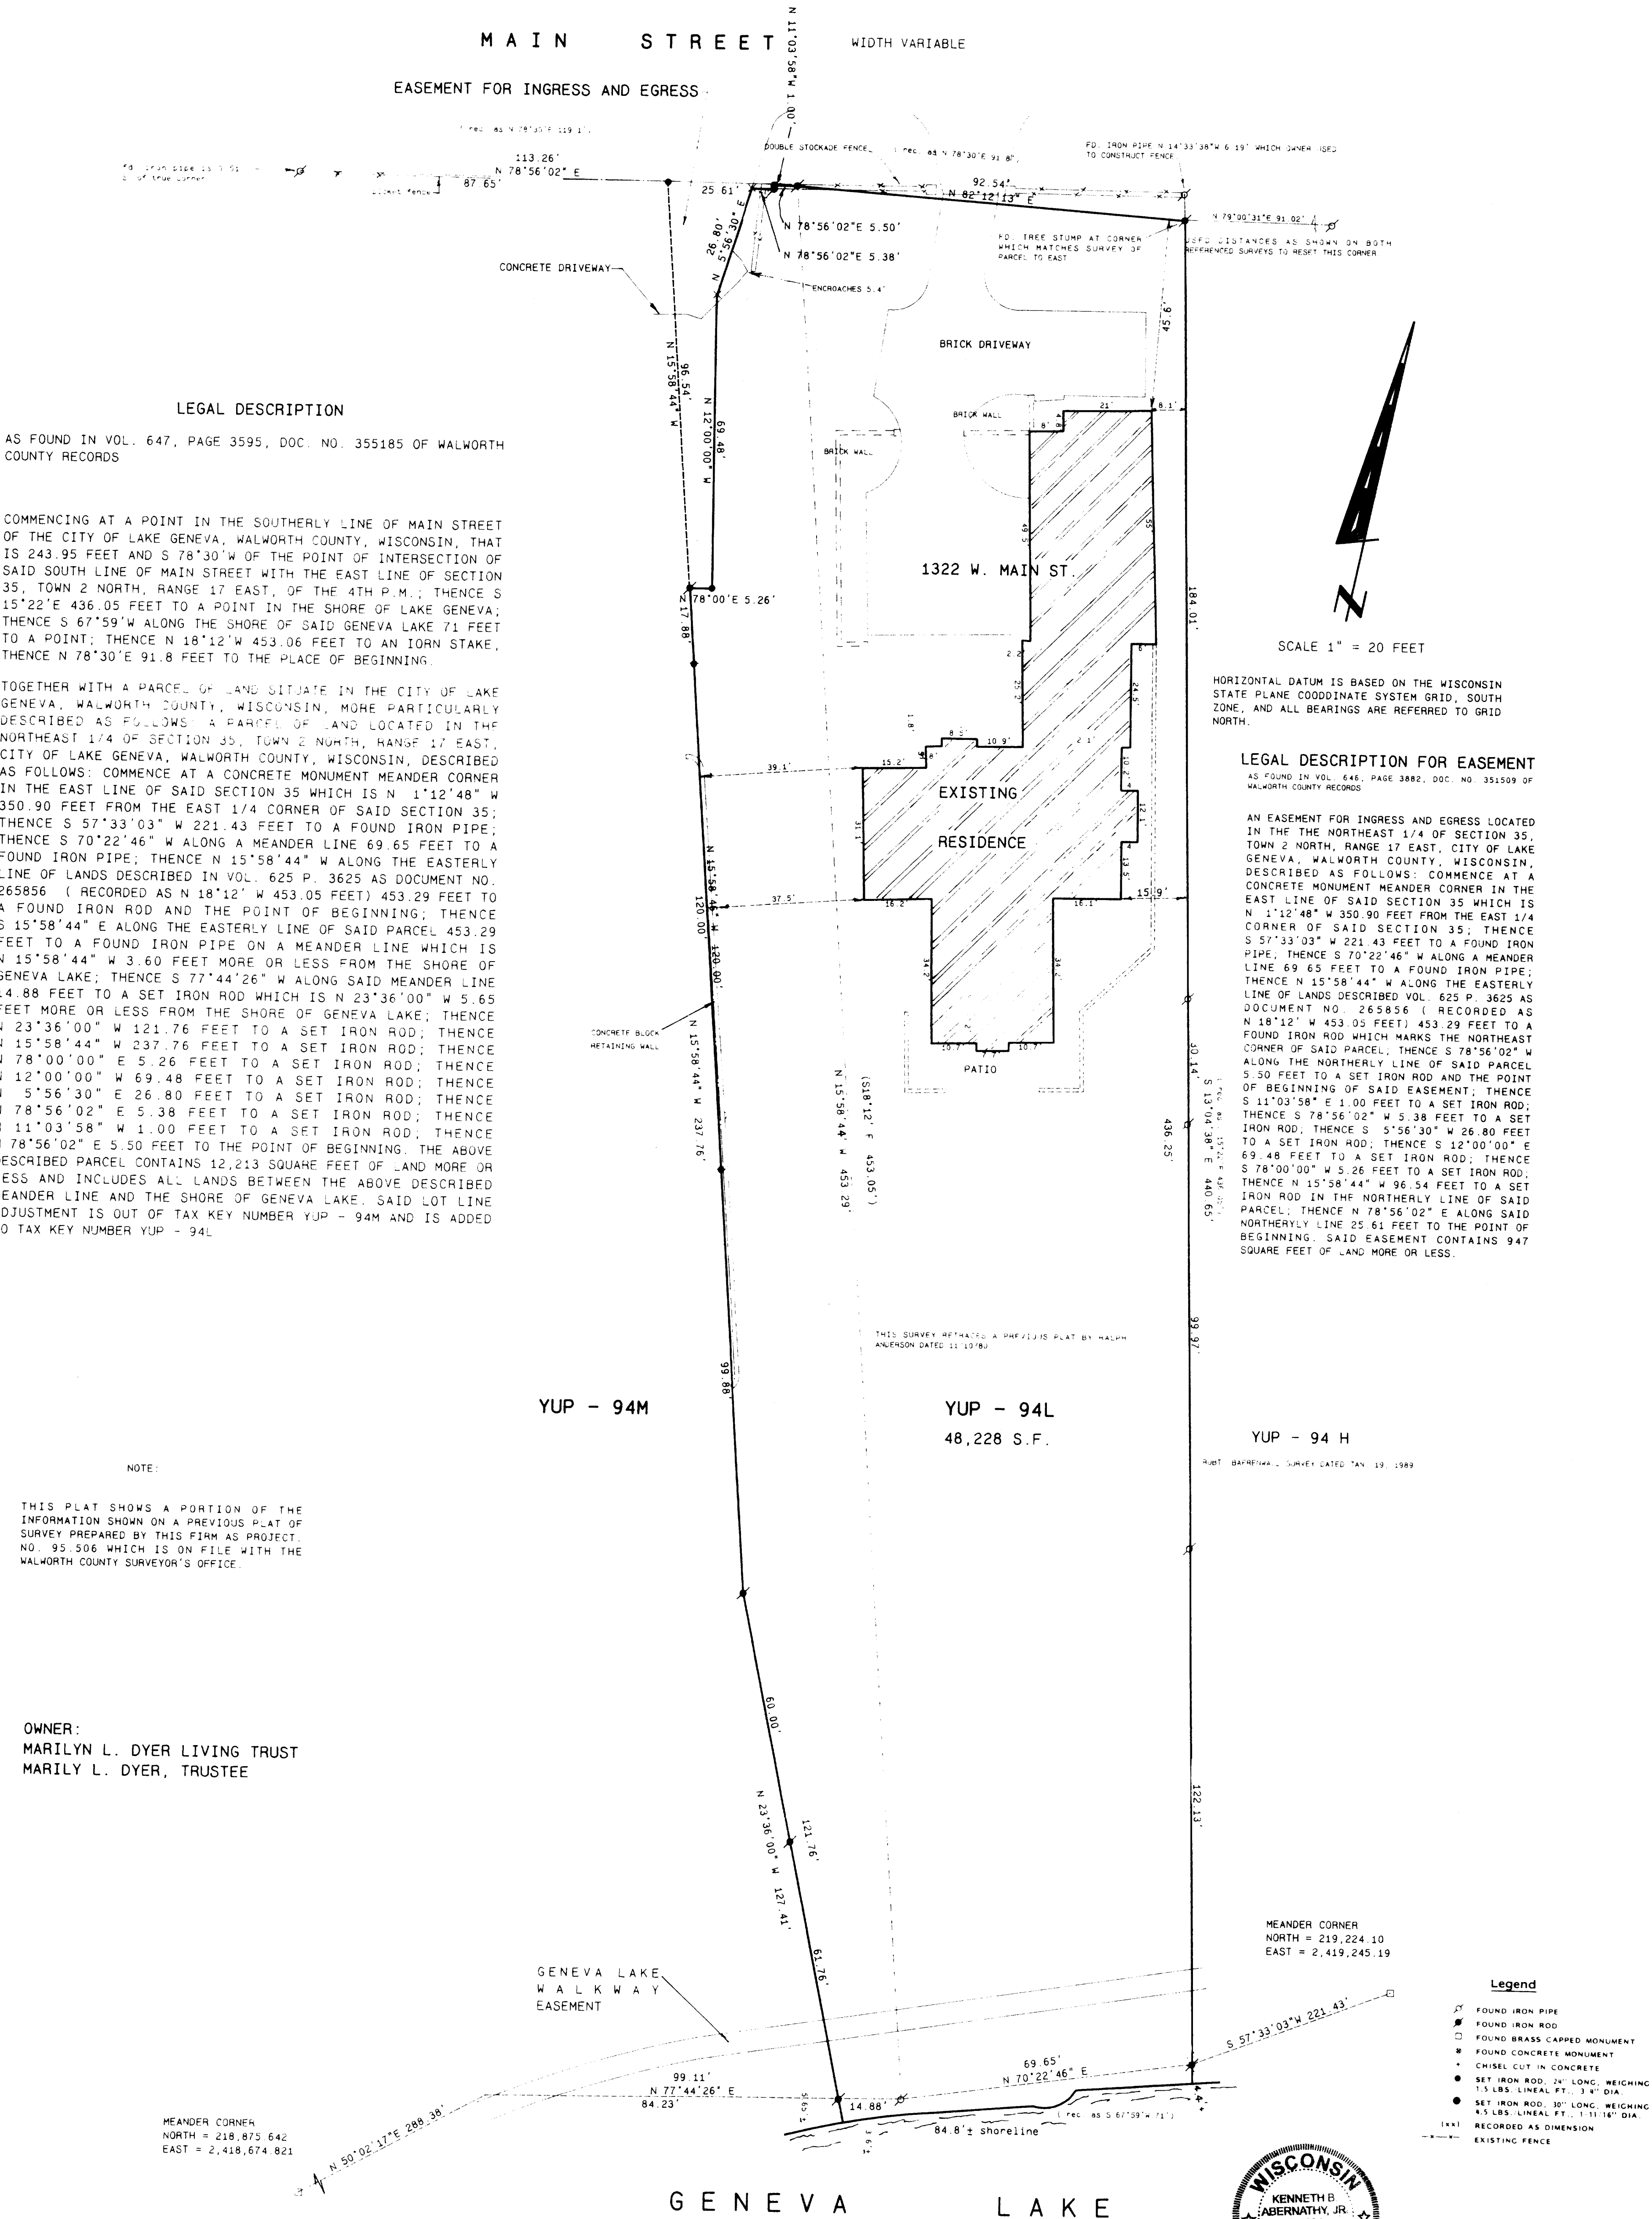

REVISED 5-4-1997
REVISED 10-29-2002

I hereby certify that the above described property has been surveyed by me in order to determine the location and boundaries of the property and to show the location of all visible structures and easements, roadways and utility encroachments, if any. This survey is made for the use of the present owners of the property and shall be valid for the purpose of the survey for the term of the survey.

Kenneth B. Abernathy, Jr.
KENNETH B. ABERNATHY, JR.
WISCONSIN REGISTERED LAND SURVEYOR,
S-1594
Date: JAN. 19, 1996 Job No. 96.104