


WILLIAMS STREET

WALKER STREET

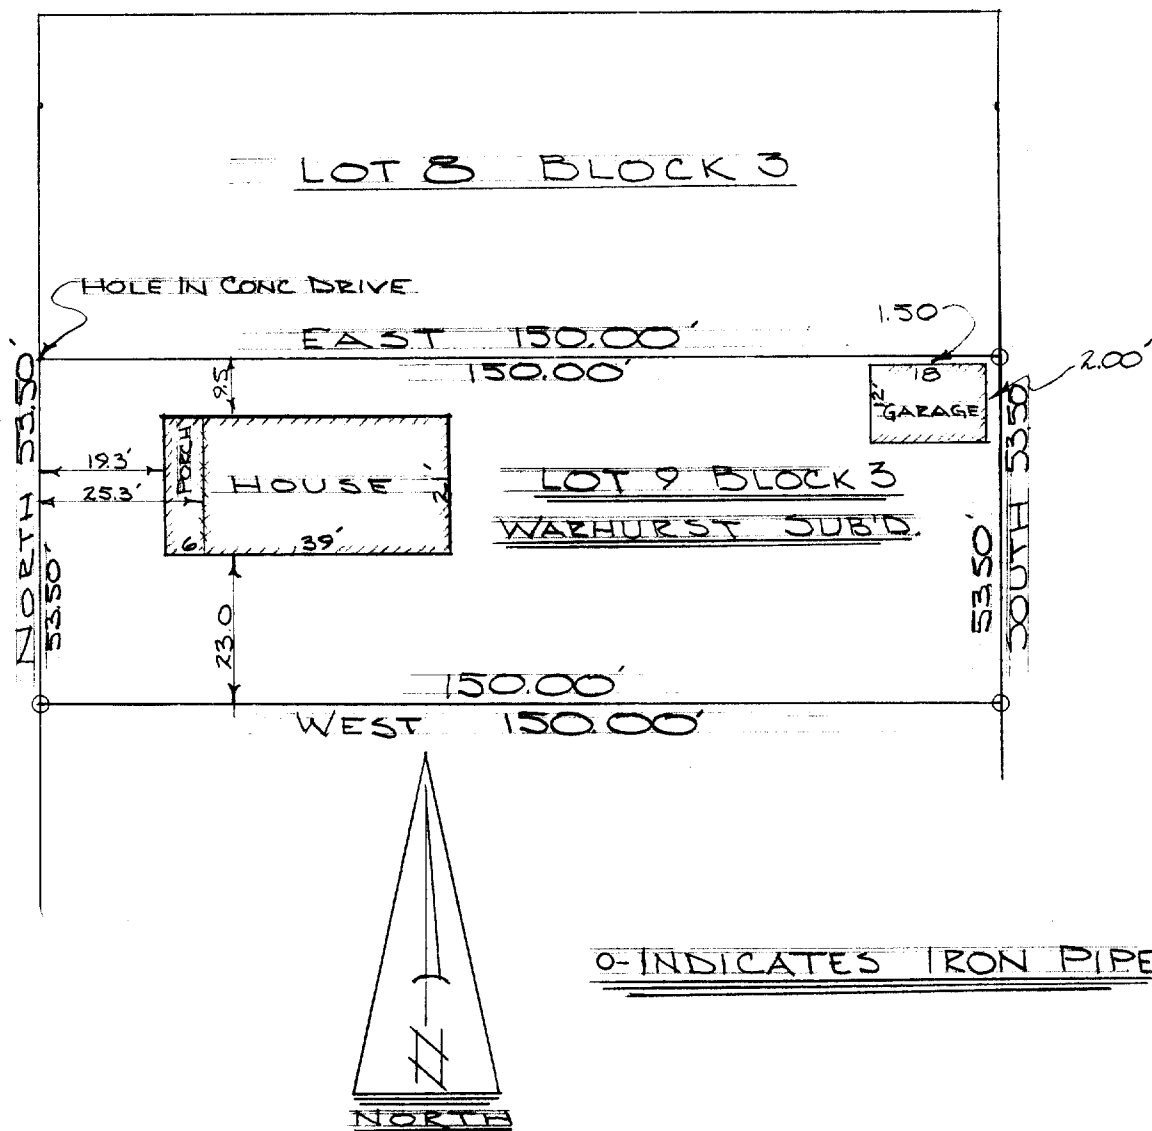


O-INDICATES IRON PIPE

DESCRIPTION: Lot 9 of Block 3 of Warhurst's Subdivision in the City of Lake Geneva, Walworth County, Wisconsin.

CERTIFICATE: I, hereby certify that I have surveyed the above mentioned property and that the above plat is an accurate survey and and a true representation thereof and correctly shows the exterior boundary lines and location of buildings and other improvements on said property and the correct measurements thereof.

September 11, 1965.

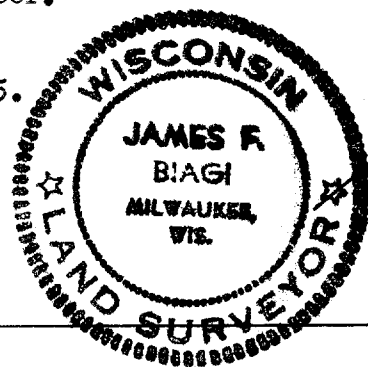

James F. Biagi
James F. Biagi RLS 272
Elkhorn, Wisconsin