
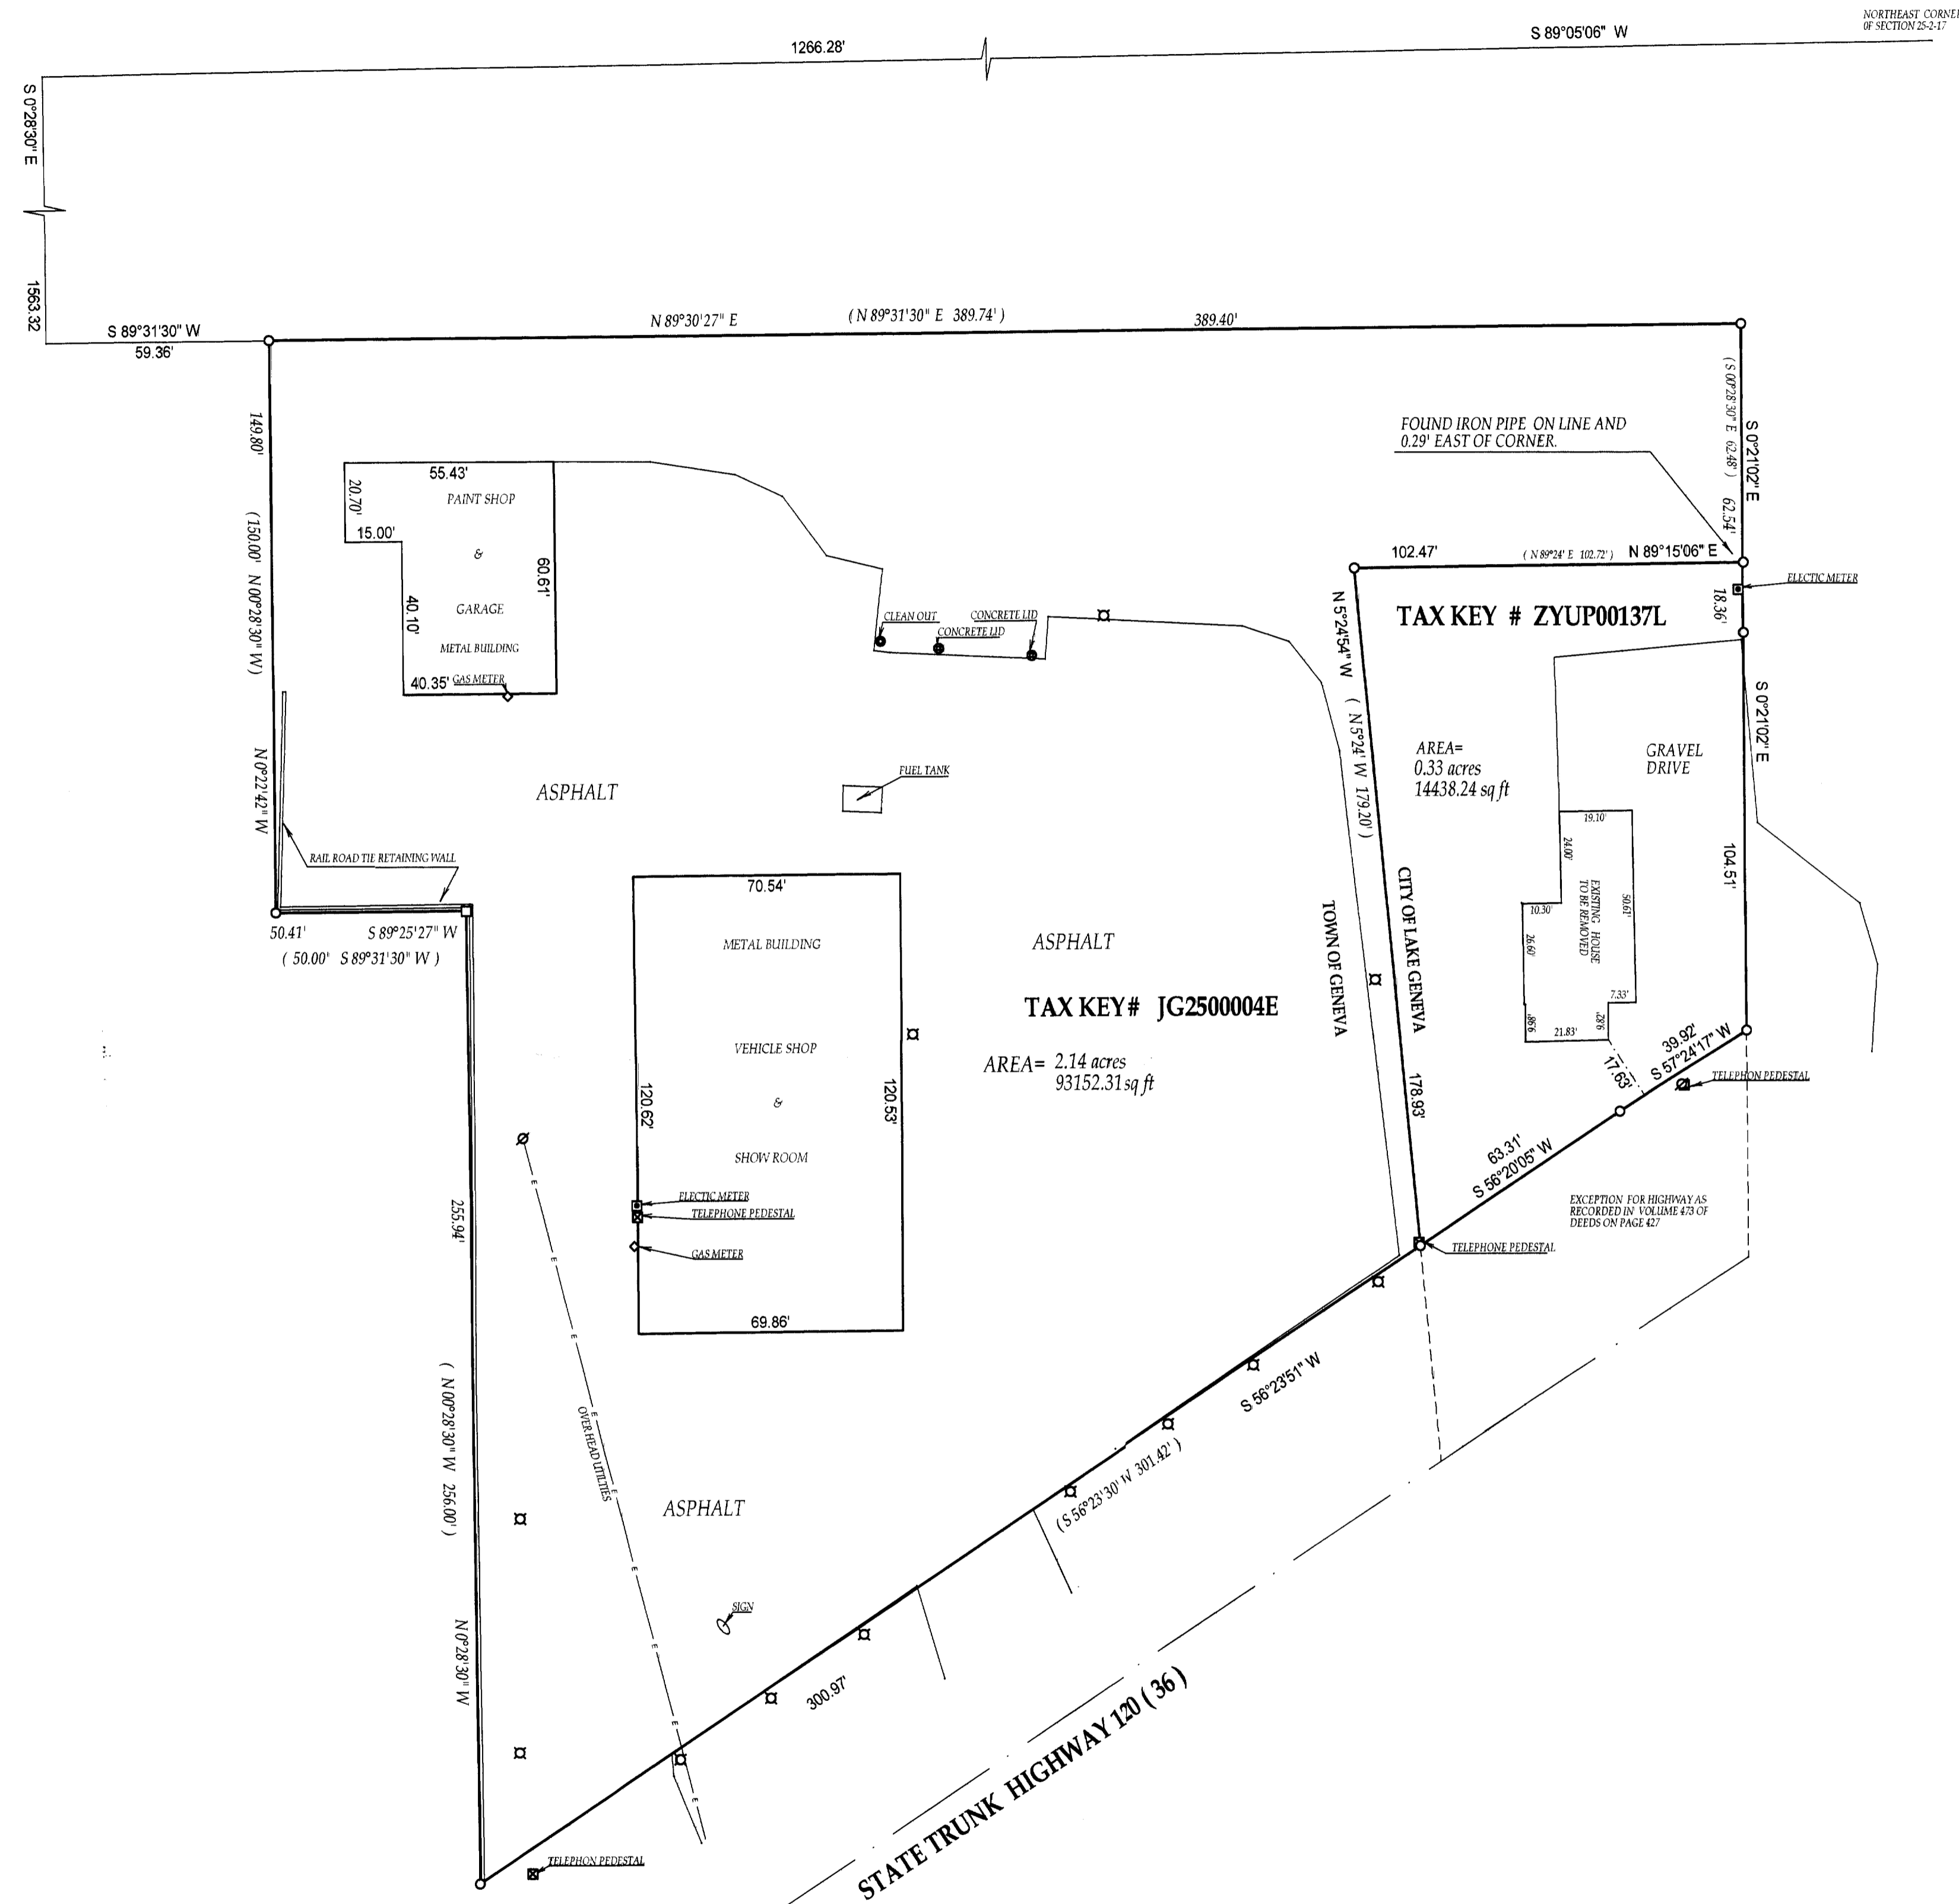


PREPARED FOR:
GENEVA LAKES FORD
HWY 120 E
LAKE GENEVA, WI
53147

J.K. SURVEYING INC.
N3705 WILLOWBEND LANE
LAKE GENEVA, WI, 53147
262-248-3697

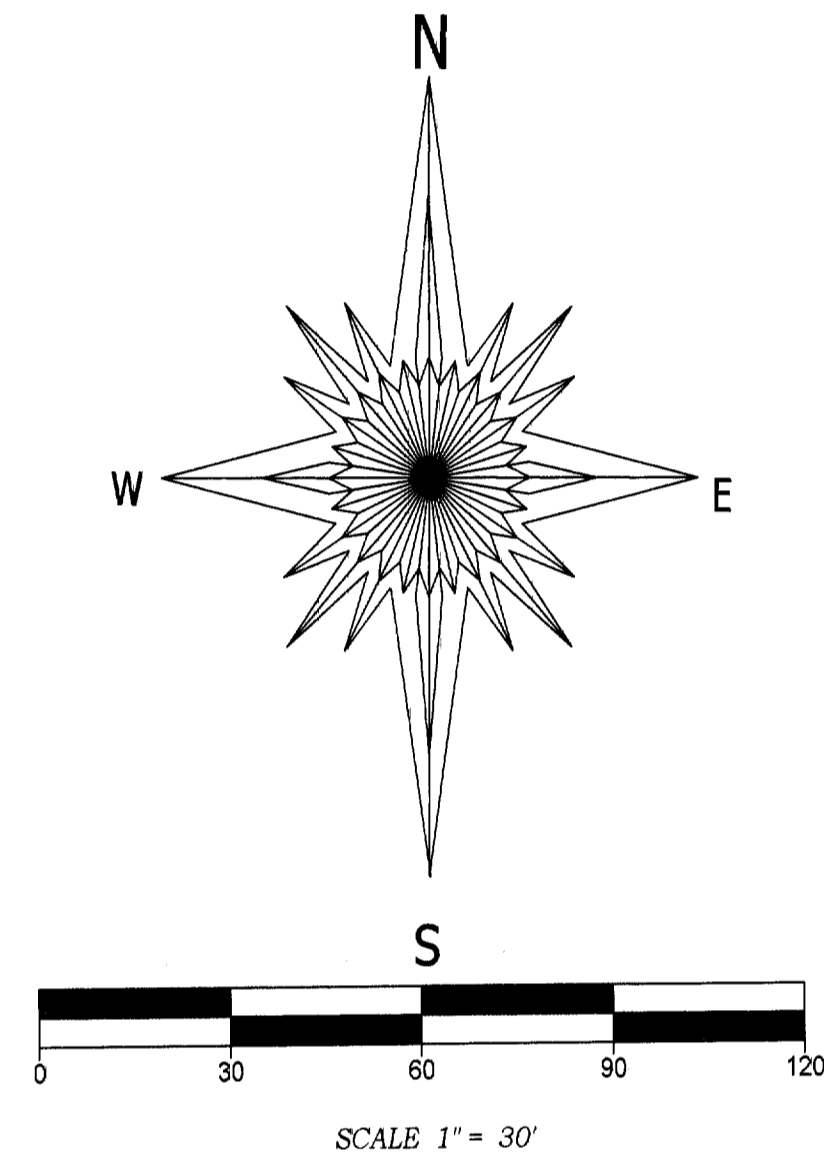

PLAT OF SURVEY

PARCEL "A"
A PARCEL OF LAND LOCATED IN THE NORTHEAST 1/4 OF SECTION 25, T.2.N., R.17.E., WALWORTH COUNTY, WISCONSIN AND DESCRIBED AS FOLLOWS, TO-WIT: COMMENCING AT THE NORTHEAST CORNER OF SAID SECTION 25; THENCE SOUTH 89°05'06" WEST, 1226.28 FEET; THENCE SOUTH 0°28'30" EAST, 1563.32 FEET; THENCE NORTH 89°31'30" EAST, 389.74 FEET TO THE PLACE OF BEGINNING; THENCE CONTINUE NORTH 89°31'30" EAST, 389.74 FEET; THENCE SOUTH 0°28'30" EAST, 42.48 FEET; THENCE SOUTH 89°24' WEST, 102.72 FEET; THENCE SOUTH 5°24' EAST, 179.20 FEET; THENCE SOUTH 56°23'30" WEST, 301.42 FEET; THENCE NORTH 0°28'30" WEST, 256.00 FEET; THENCE SOUTH 89°31'30" WEST, 50.00 FEET; THENCE NORTH 0°28'30" WEST, 150.00 FEET TO THE PLACE OF BEGINNING.

PARCEL "B"
A PARCEL OF LAND LOCATED IN THE NORTHEAST 1/4 OF SECTION 25, T.2.N., R.17.E., WALWORTH COUNTY, WISCONSIN DESCRIBED AS FOLLOWS, TO-WIT: COMMENCING AT THE NORTHEAST CORNER OF SAID SECTION 25; THENCE SOUTH 89°05'06" WEST, 1226.28 FEET; THENCE SOUTH 0°28'30" EAST, 1563.32 FEET; THENCE NORTH 89°31'30" EAST, 389.74 FEET TO THE PLACE OF BEGINNING; THENCE CONTINUE NORTH 89°31'30" EAST, 389.74 FEET; THENCE SOUTH 0°28'30" EAST, 42.48 FEET; THENCE SOUTH 89°24' WEST, 102.72 FEET; THENCE SOUTH 5°24' EAST, 179.20 FEET; THENCE SOUTH 56°23'30" WEST, 301.42 FEET; THENCE NORTH 0°28'30" WEST, 256.00 FEET; THENCE SOUTH 89°31'30" WEST, 50.00 FEET; THENCE NORTH 0°28'30" WEST, 150.00 FEET TO THE PLACE OF BEGINNING.


- LEGEND
- light pole
 - () = recorded as
 - = found iron bar
 - = found iron pipe
 - = set iron pipe
 - = set iron bar
 - ⊙ = power pole

SCALE 1" = 30'

JOB # 03-026

TAX ID # ZYUP 00137L


JG 25-4E

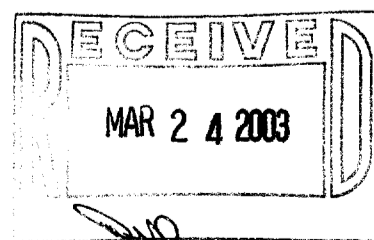

COMPARE LEGAL DESCRIPTION ABOVE AND DRAWING WITH DEED, FOR BUILDING RESTRICTIONS AND EASEMENTS NOT SHOWN REFER TO DEED, ABSTRACT SOURCES AND LOCAL MUNICIPAL CODES. NOTIFY THE SURVEYOR IMMEDIATELY OF ANY DISCREPANCY.

"I hereby certify that I have surveyed the above described property and that the above map is a true representation thereof and shows the size and location of all visible structures, apparent easements and encroachments if any."
This survey is made for the present owners of the property, and those who purchase, mortgage, or guarantee the title thereto, within one year from the date hereof.

DATED THIS 17th, DAY OF JANUARY, 2003

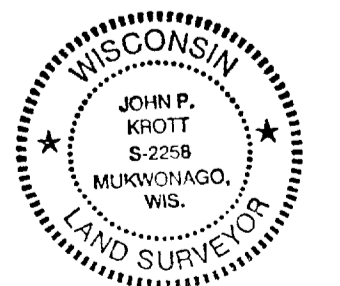

John P. Krott
JOHN KROTT S-2258
Wisconsin Registered Land Surveyor
(original if signed in red)