PLAT OF SURVEY


- OF -

J.K. SURVEYING INC. N3705 WILLOWBEND LANE LAKE GENEVA, WI, 53147 262-248-3697

UNITS 404,504,604,704,804 AND 904 OF GENEVA TOWERS CONDOMINIUM (WEST TOWER) LOCATED AT 101 BROAD STREET, LAKE GENEVA, WISCONSIN. AS IT IS SHOWN ON PARCÉL "A" TOGETHER WITH OTHER PARCELS AND EASEMENTS AS DEFINED IN THE CONDOMINIUM OWNERSHIP DECLARATIONS, AND THE PLAT DEFINED AS EXIBIT "A".

PARCEL A: THAT PART OF SECTION 36, TOWN 1 NORTH, RANGE 17 EAST OF THE FOURTH PRINCIPAL MERIDIAN. IN BLOCK 30 OF THE ORIGINAL PLAT OF THE CITY OF LAKE GENEVA, DISCRIBES AS FOLLOWS:

BEGINING AT THE NORTHWEST CORNER OF SAID BLOCK 30; THENCE SOUTH 183.35 FEET; THENCE SOUTH 18 DEGREES 34 MINUTES EAST, 90.83 FEET; THENCE SOUTH 28 DEGREES 40 MINUTES EAST, 2.04 FEET; THENCE NORTH 61 DEGREES 40 MINUTES EAST, 9.42 FEET; THENCE NORTH 81 DEGREES 02 MINUTES EAST, 49.84 FEET; THENCE NORTH 72 DEGREES 02 MINUTES EAST, 16.57 FEET; THENCE NORTH 60 DEGREES 25 MINUTES EAST, 88.64 FEET; THENCE NORTH 62 DEGREES 24 MINUTES EAST, 12.55 FEET; THENCE NORTH 00 DEGREES 06 MINUTES WEST, 203.19 FEET; THENCE NORTH 89 DEGREES 48 MINUTES WEST. 190.85 FEET, TO THE POINT OF BEGINING, IN THE CITY OF LAKE GENEVA, WALWORTH COUNTY, WISCONSIN.

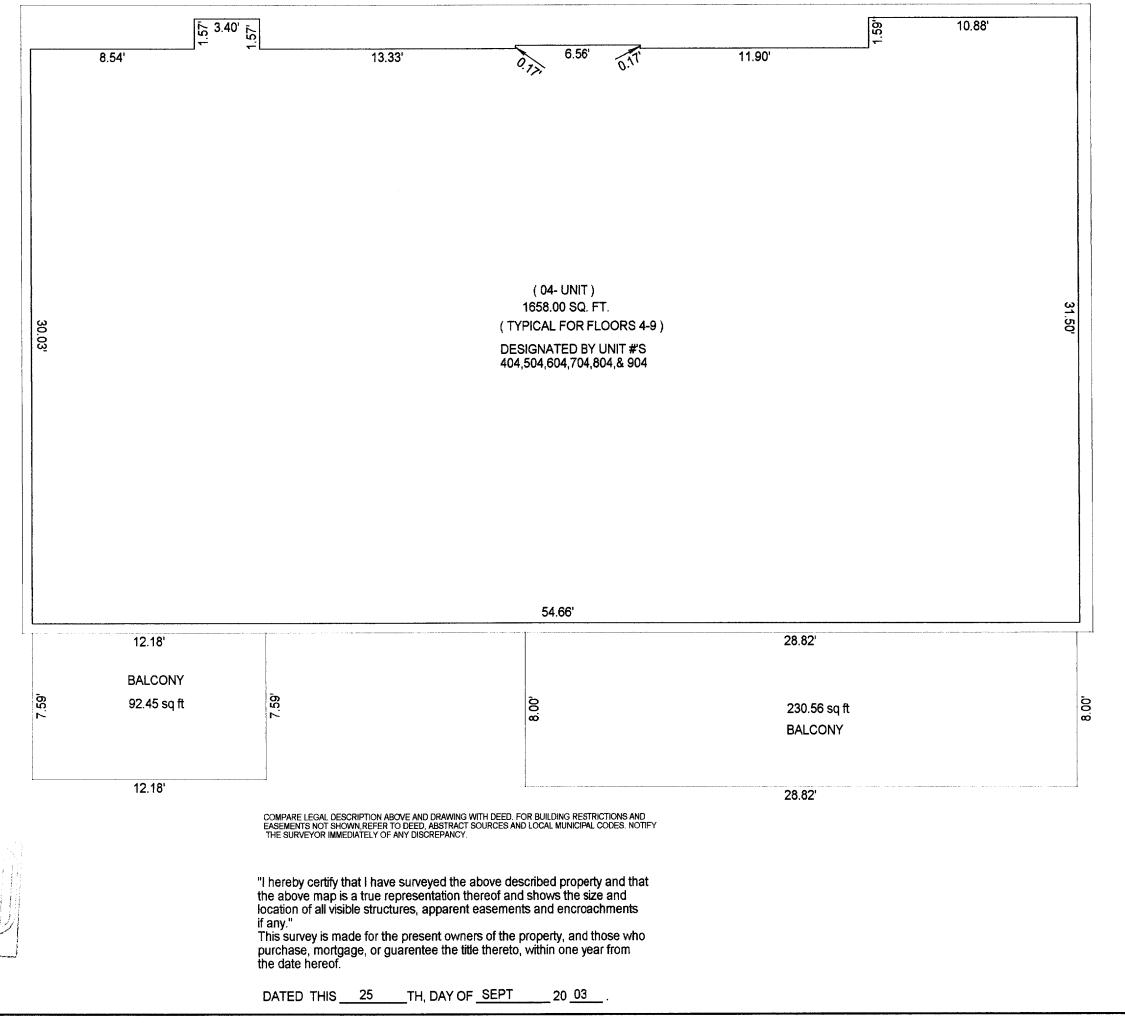

MISCONS JEFFERY L KIMPS 2436 LAKE GENEVA, WIS. JEFFREY L KIMPS S - 2436 Wisconsin Registered Land Surveyor

(original if signed in red)

ZCNG-25

TAXID #ZCNG - 21

ZCNG-41

ZC NG - 29 ZC NG - 33 ZC NG - 37

()= recorded as

o = iron pipe

found

= iron pipe

SCALE 1" = 5'

JOB # 03-072 04UNIT

SEP 2 6 2003