


LAKE GENEVA BLVD

LAURIE STREET

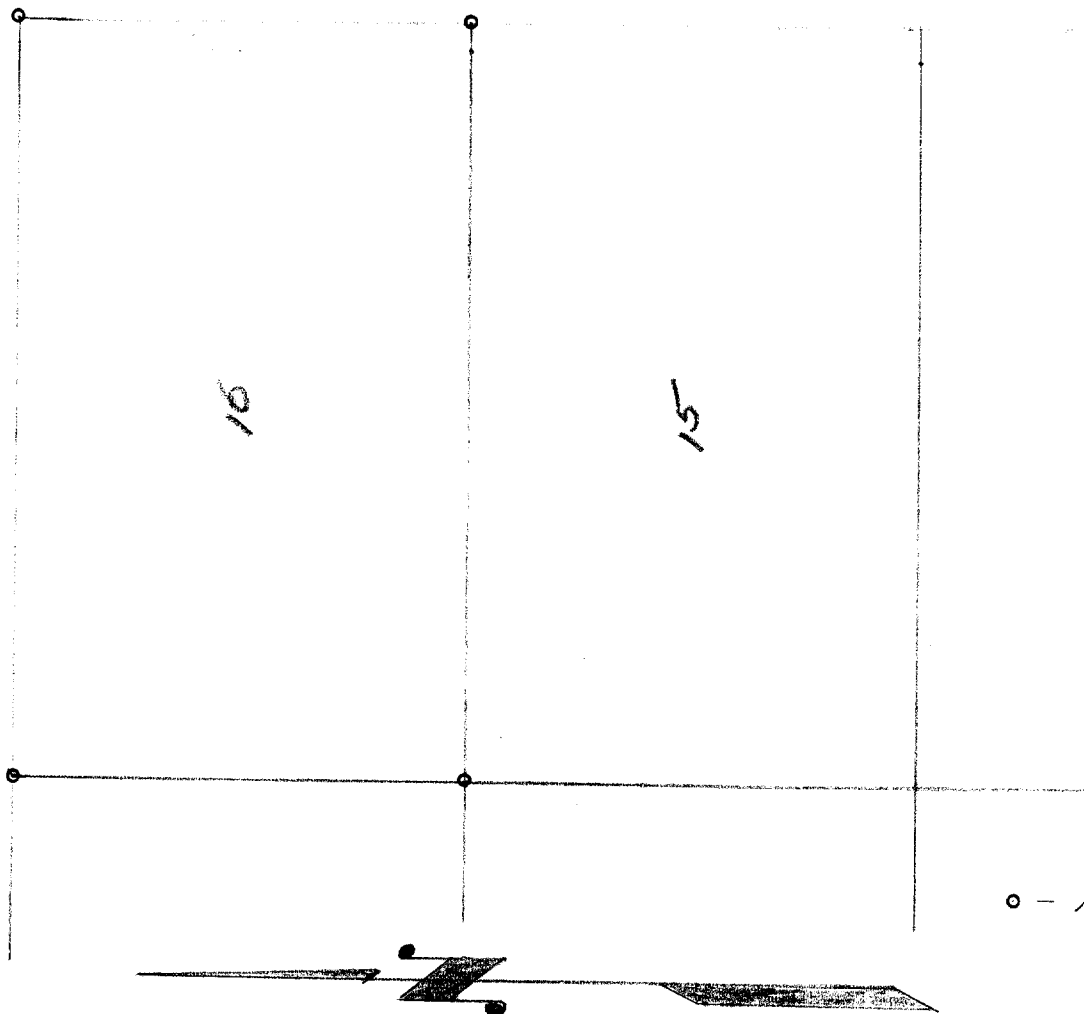

○ - IRON STAKE

DESCRIPTION: Lot 16, H. E. Wells Subdivision of a portion of the City of Lake Geneva, Walworth County, Wisconsin.
 CERTIFICATE: I, hereby certify that I have on this the 8th day of October 1955, surveyed the above described property according to the official records on file in the office of the Recorder of Deeds for Walworth County, Wisconsin, and find that no encroachments exist.
 SIGNED AND SEALED ON THIS THE 14TH DAY OF OCTOBER, 1955.

James F. Biagi
 James F. Biagi, Surveyor.

Joseph M. Biagi
 Joseph M. Biagi, Professional Engineer.
 Elkhorn Wisconsin.

7-214B