
FARRIS, HANSEN, & ASSOCIATES, INC.

ENGINEERING, ARCHITECTURE, SURVEYING
7 RIDGWAY COURT — P.O. BOX 437, ELKHORN, WISCONSIN, 53121
PHONE: (414) 723—2098 FAX: (414) 723—5886
PLAT OF SURVEY

LOTS 4, 5, 6, & 38
EXCEPTING THE SOUTH 5 FEET LOT 38
PARADISE VISTA

LOCATED IN THE SE 1/4 SECTION 1 TOWN 1 NORTH, RANGE 17 EAST WALWORTH COUNTY, WISCONSIN

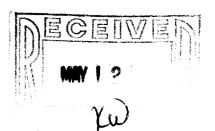

90

EL 80

E 70

₽6

30

.5


ΑP

SCALE

≥ ₽8

- WORK ORDERED BY -SYDNEY BORST 2115 RIDGE ROAD LAKE GENEVA, WI. 53147

O = FOUND IRON PIPE STAKE (XXX) = RECORDED AS

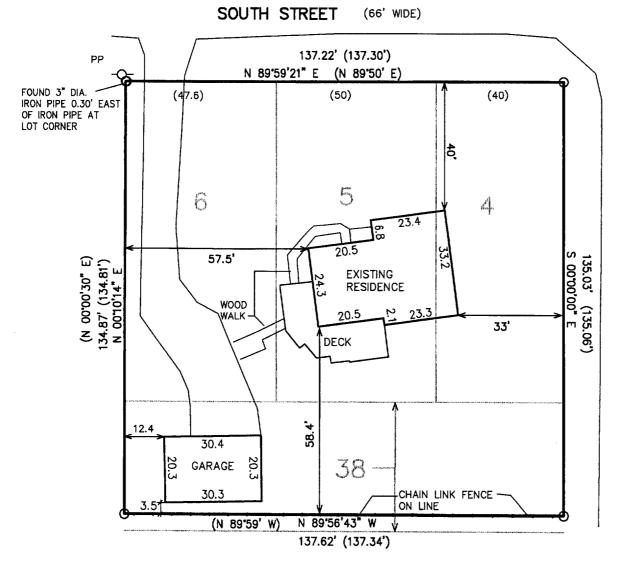

WILMOT BOULEVARD

(40°WIDE)

ORIGINAL 1" = 30'

ASSIGNED WEST LINE WILMOT BOULEVARD S 00 00' 00" E

NOTE: COPIES OF THIS MAP TO WHICH THE FOLLOWING CERTIFICATE WILL APPLY SHOW SURVEYOR'S ORIGINAL SEAL AND SIGNATURE IN RED INK. COPIES BY ANY OTHER MEANS MAY HAVE ALTERATIONS WHICH DO NOT REPRESENT THE SURVEYOR'S WORK PRODUCT.

I HEREBY CERTIFY THAT THE ABOVE DESCRIBED PROPERTY HAS BEEN SURVEYED UNDER MY DIRECTION AND THAT THE ABOVE MAP IS A TRUE REPRESENTATION THEREOF AND SHOWS THE SIZE AND LOCATION OF THE PROPERTY, ITS EXTERIOR BOUNDARIES, THE LOCATION OF ALL VISIBLE STRUCTURES, AND DIMENSIONS OF ALL PRINCIPLE BUILDINGS THEREON, BOUNDARY FENCES, APPARENT EASEMENTS, ROADWAYS, AND VISIBLE ENCROACHMENTS, IF ANY. THIS SURVEY IS MADE FOR THE USE OF THE PRESENT OWNERS OF THE PROPERTY, AND ALSO THOSE WHO PURCHASE, MORTGAGE, OR GUARANTEE THE TITLE THERETO WITHIN ONE YEAR FROM THE DATE HEREOF.

I FURTHER CERTIFY THAT THE LANDS SURVEYED FALL IN FLOOD HAZARD AREA "C" (AREAS OF MINIMAL FLOODING), AS SHOWN ON FLOOD INSURANCE RATE MAP PANEL NO. 550466 0003 B, EFFECTIVE DATE OF DECEMBER 1, 1982 AS PUBLISHED BY THE FEDERAL EMERGENCY MANAGEMENT AGENCY.

DATED: APRIL 21, 2004

海野 女生 知道

PETER S. GORDON R.L.S. 2101

PROJECT 2620_04 DATE: 04-21-2004 SHEET 1 OF 1