

- OF -

LOT 42

CHAINLINK FENCE IS 1.02' NORTH OF LINE

(S 89°04'00" E 120.00')
(S 89°04'52" E 120.08')

51.94'

8.42'

25.12'

28.65'

57.10'

7.70'

13.10'

28.45'

16.38'

15.35'

41.50'

25.73'

9.00'

9.00'

5.91'

(N 89°08'12" W 120.03')
(N 89°04'00" W 120.00')

EXISTING RESIDENCE

CONCRETE PATIO

BRICK WALK

DECK OVER GARAGE

ASPHALT DRIVE

LOT 41

NORTH 9' OF LOT 40

SOUTH 58' OF LOT 40


(N 0°30'00" E 72.00')
(N 0°27'26" E 72.05')
(63.00')


(63.00')
(71.93')
(72.00')

ELMWOOD AVENUE
(60' WIDE)

SCALE: 1" = 20'
JOB #: 04-157
TAX ID #: ZST 00040

"I hereby certify that I have surveyed the above described property and that the above map, to the best of my knowledge and belief, is a true representation thereof and shows the size and location of all visible structures, apparent easements and encroachments if any."
This survey is made for the present owners of the property, and those who purchase, mortgage, or guarantee the title thereto, within one year from the date hereof.

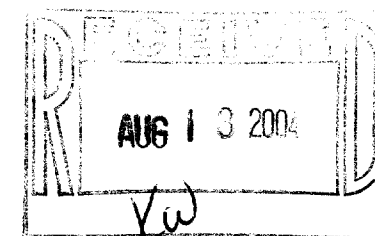


JEFFREY L KIMPS S - 2436
Wisconsin Registered Land Surveyor
(original if signed in red)
DATED THIS 6th DAY OF APRIL, 2004

007-2203