
SURVEY FOR: TALON BUILDERS LOCATION:

DOGEWOOD DRIVE

BAIOR

DESCRIPTION: LOT 37 EDDGEWOOD HILLS, a subdivision located in the Southwest 1/4 and the Southeast 1/4 of the Northeast 1/4 and the Northeast 1/4 and the Northwest 1/4 of the Southeast 1/4 of Section 26, Town 2 North, Range 17 East, Town of Geneva and City of Lake Geneva,

Walworth County, Wisconsin.

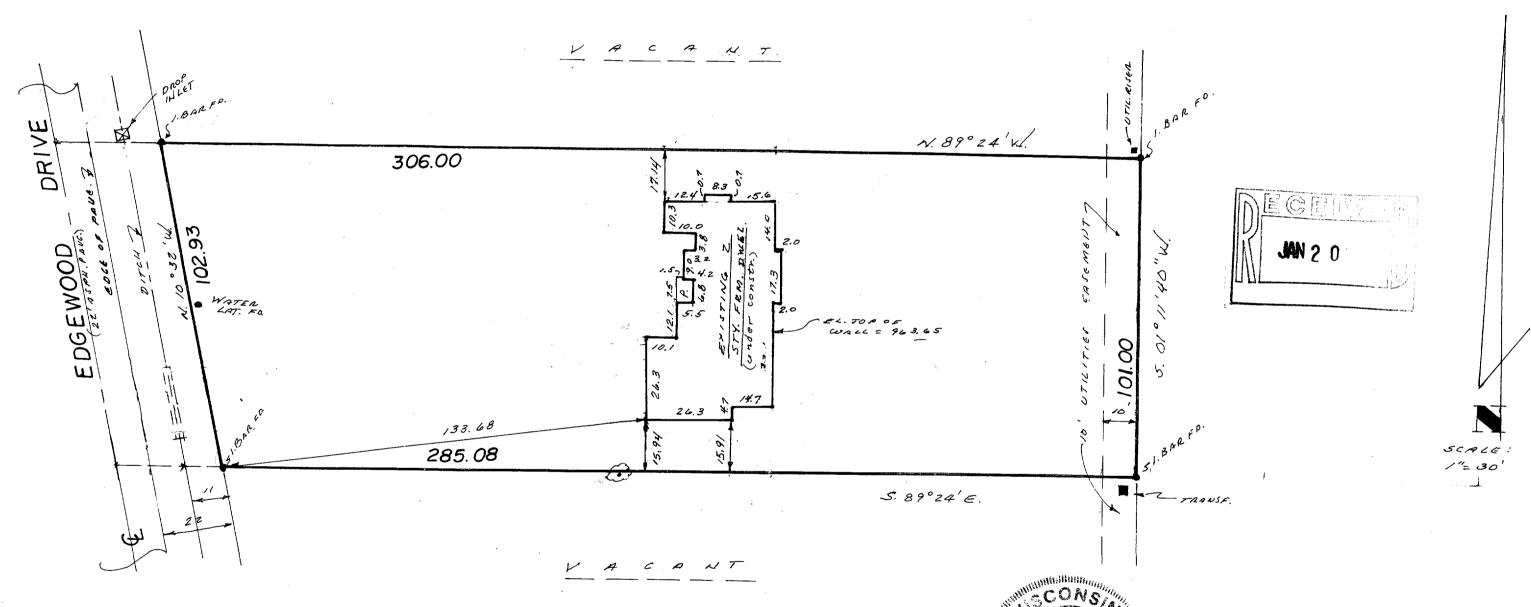

SURVEY CERTIFICATE

State of Wisconsin) Milwaukee County)ss

We, Interline Survey Services, Inc., certify that we have surveyed the above described property and the above map is a true representation thereof, and shows the size and location of the property, its exterior boundaries, the location and dimensions of all visible structures thereon, fences, apparent easements and roadways and visible encroachments, if any.

This survey is made for the exclusive use of the present owners of the Property, and also those who purchase, mortgage, or guarantee the title thereto, within one (1) year from date hereof.

Wisconsin Redistered Land Surveyor



GARY

SMITH

2195

AILWAUKEE,

INTERLINE SURVEY SERVICES, INC. 10521 W. FOREST HOME AVE. STE. 201 HALES CORNERS, WI 53130 PHONE 425-2060

DATED: 4-13-04

007-2229