

FARRIS, HANSEN & ASSOCIATES, INC.


ENGINEERING – ARCHITECTURE – SURVEYING
7 RIDGWAY COURT – P.O. BOX 437 – ELKHORN, WISCONSIN 53121
PHONE: (262) 723-2098 FAX: (262) 723-5886

PLAT OF SURVEY

LOT 37 OF MEADOWLAND SUBDIVISION

LOCATED IN SECTION 31, TOWN 2 NORTH, RANGE 18 EAST,
CITY OF LAKE GENEVA, WALWORTH COUNTY, WISCONSIN


– WORK ORDERED BY –
BASSO BUILDERS
405 SKYLINE DRIVE
LAKE GENEVA, WI. 53147

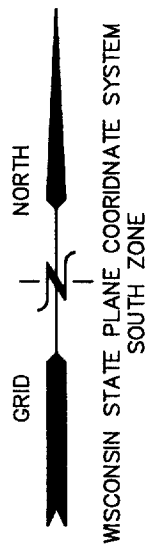


LEGEND

- = FOUND IRON REBAR STAKE
- {XXX} = RECORDED AS

NOTE: SIDE YARD SETBACKS ARE
TO BE A MINIMUM OF 6'
THAT TOTAL TO 15'

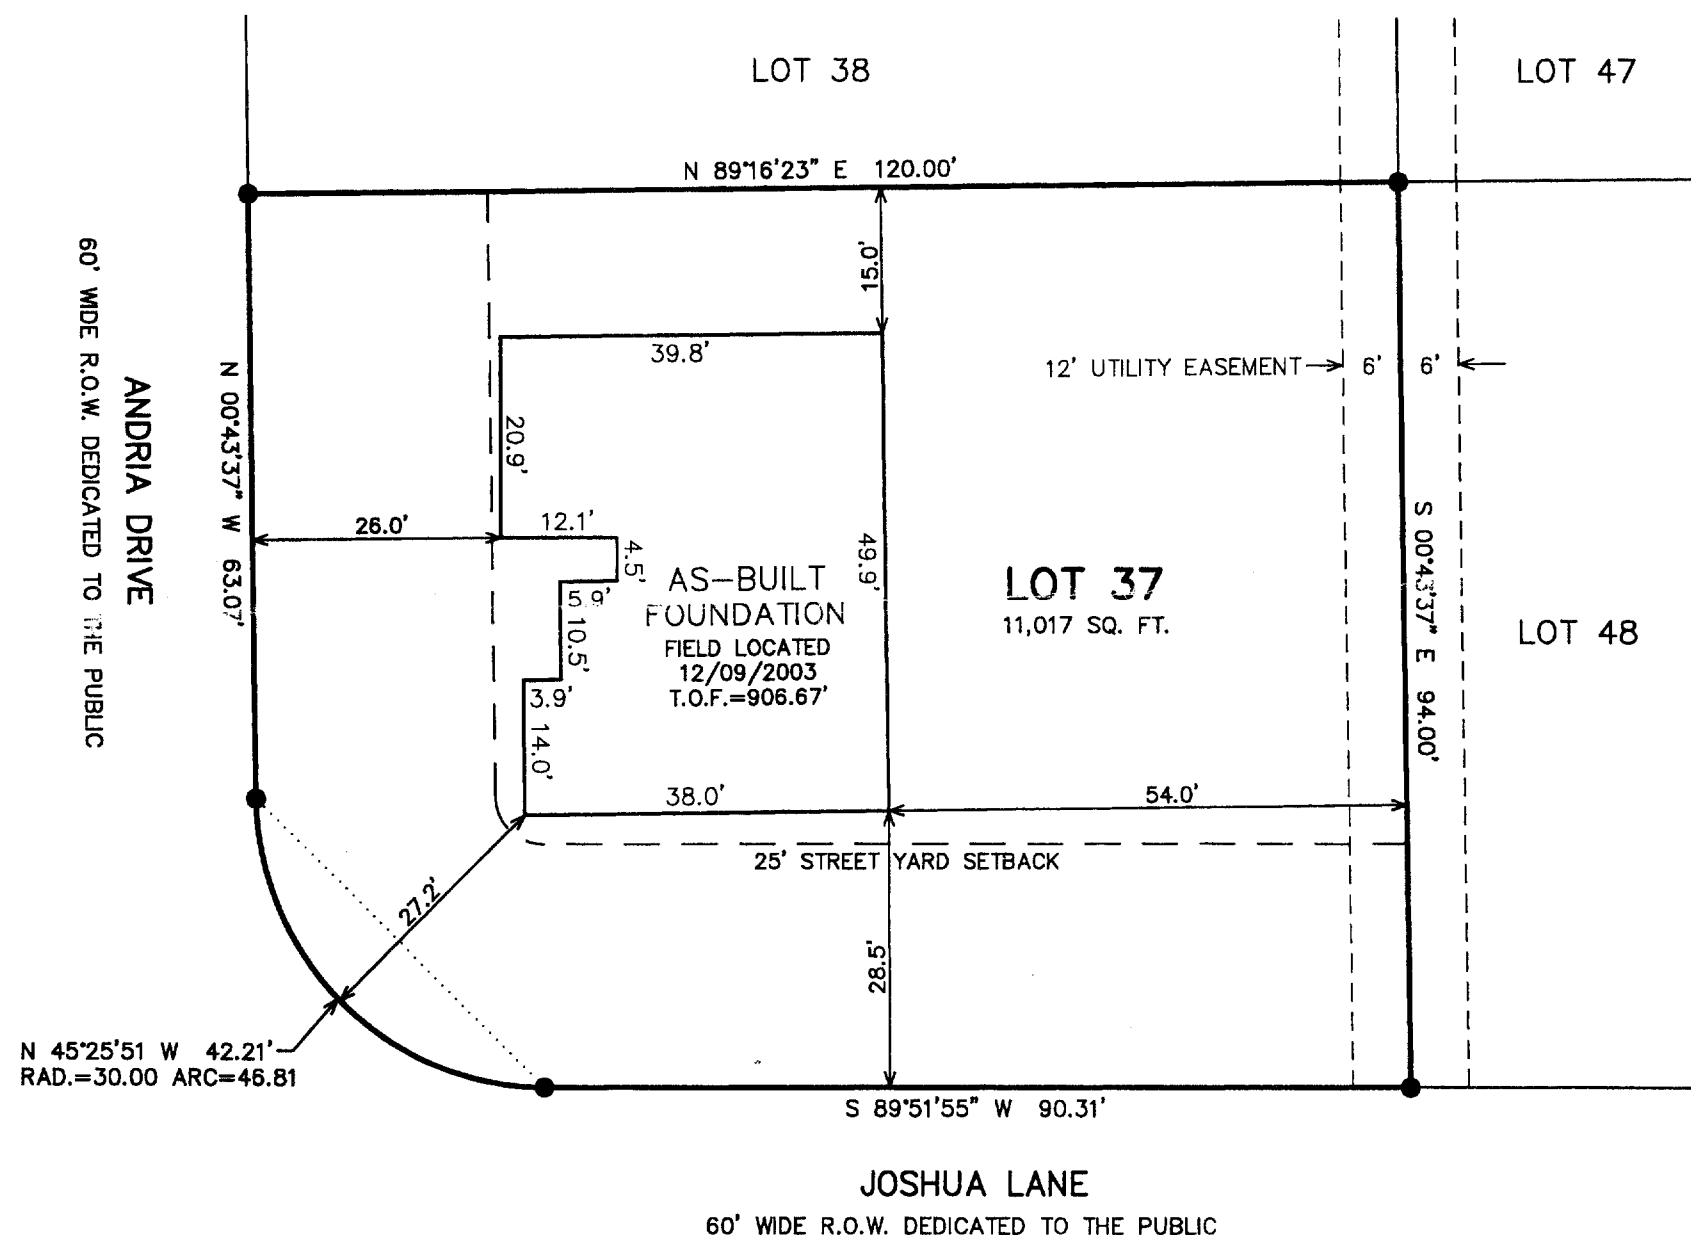

10 5 0 10 20 30 40 50 60 70 80 90 100
MAP SCALE IN FEET ORIGINAL 1" = 20'

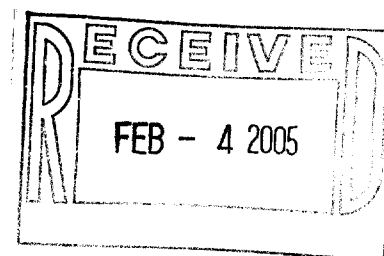

NOTE: COPIES OF THIS MAP TO WHICH THE FOLLOWING CERTIFICATE WILL APPLY SHOW THE SURVEYOR'S ORIGINAL SEAL AND SIGNATURE IN RED INK. COPIES BY ANY OTHER MEANS MAY HAVE ALTERATIONS WHICH DO NOT REPRESENT THE SURVEYOR'S WORK PRODUCT.

I HEREBY CERTIFY THAT THE ABOVE DESCRIBED PROPERTY HAS BEEN SURVEYED UNDER MY DIRECTION AND THAT THE ABOVE MAP IS A TRUE REPRESENTATION THEREOF AND SHOWS THE SIZE AND LOCATION OF THE PROPERTY AND ITS EXTERIOR BOUNDARIES. THIS SURVEY IS MADE FOR THE USE OF THE PRESENT OWNERS OF THE PROPERTY, AND ALSO THOSE WHO PURCHASE, MORTGAGE, OR GUARANTEE THE TITLE THERETO WITHIN ONE YEAR FROM THE DATE HEREOF.

DATED: JULY 10, 2003

REVISED 12/10/2003
TO SHOW SIZE & LOCATION OF
AS-BUILT FOUNDATION

PETER S. GORDON R.L.S. 2101

PROJECT: 5970.37
DATE: 07/10/2003
SHEET 1 OF 1

ZMEA-37

007-2235