


DEGEN-FOAT SURVEYING LLC
100 SOUTH SECOND STREET
WATERFORD, WISCONSIN
(262)534-5404 (FAX)534-2022

048200
048200S1.DWG

PLAT OF SURVEY

LOT 2 OF CERTIFIED SURVEY MAP NO. 2115, RECORDED IN VOLUME 10 PAGE 119, BEING
LOCATED IN THE NORTHEAST 1/4 OF THE NORTHWEST 1/4 OF SECTION 36, TOWN 2 NORTH,
RANGE 17 EAST, CITY OF LAKE GENEVA, WALWORTH COUNTY, WISCONSIN.


PREPARED FOR: ADVANTAGE TITLE
P.O. BOX 217
TWIN LAKES, WI 53181

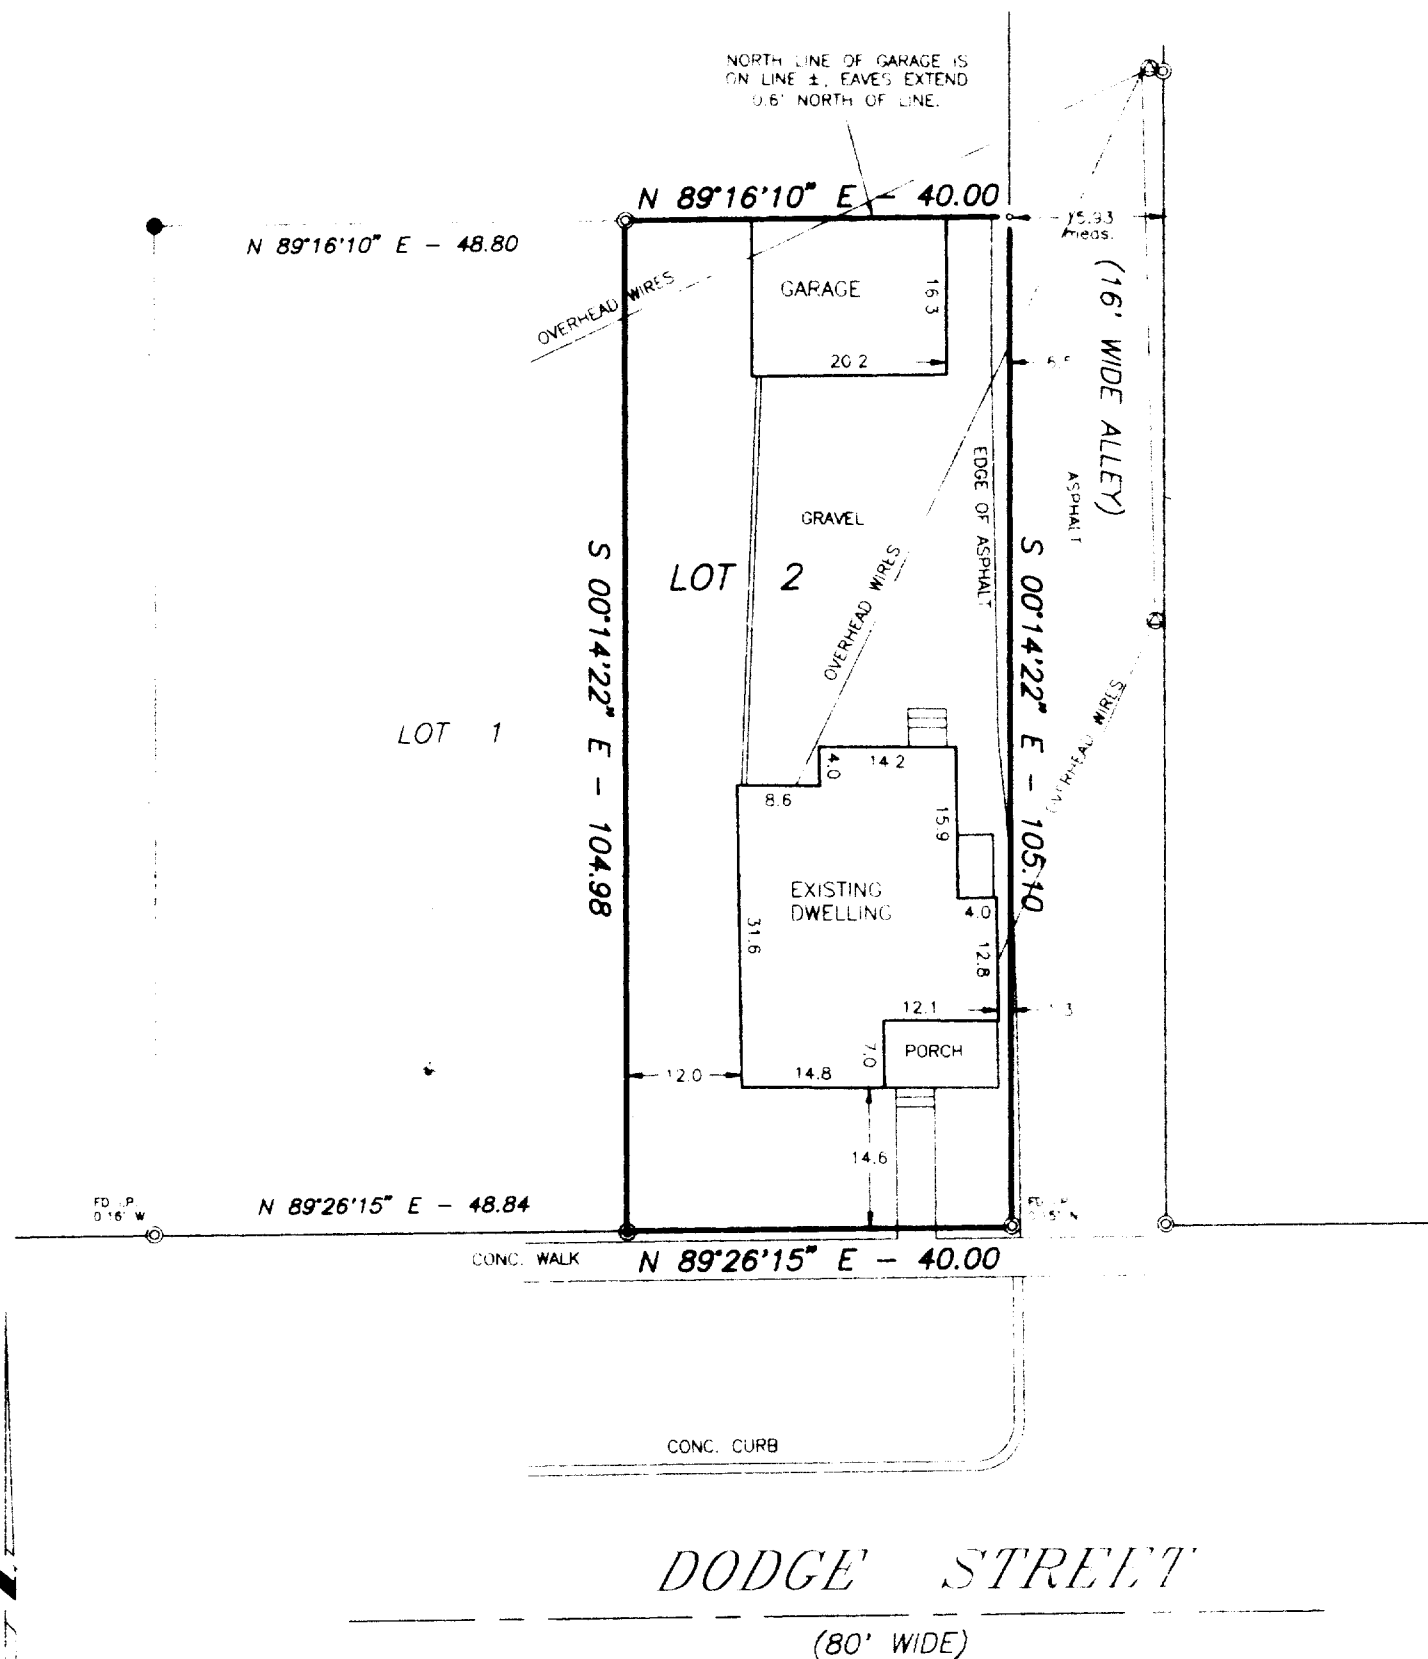

LEGEND

- - SET 60d NAIL
- ⊙ - FOUND IRON PIPE
- - FOUND IRON ROD
- - SET IRON PIPE
- () - RECORDED AS
- ⊕ - UTILITY POLE

SCALE: 1" = 20'
BEARING BASE: AS RECORDED AS

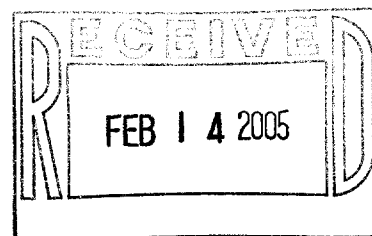

I HEREBY CERTIFY THAT I HAVE SURVEYED THE ABOVE DESCRIBED PROPERTY AND THE ABOVE MAP IS A TRUE REPRESENTATION THEREOF
AND SHOWS THE SIZE AND LOCATION OF THE PROPERTY, THE LOCATION OF ALL VISIBLE STRUCTURES AND DIMENSIONS OF ALL PRINCIPAL
BUILDINGS THEREON, BOUNDARY FENCES, APPARENT EASEMENTS, ROADWAY AND VISIBLE ENCROACHMENTS, IF ANY.

THIS SURVEY IS MADE FOR THE PRESENT OWNERS OF THE PROPERTY, AND ALSO THOSE WHO PURCHASE, OR GUARANTEE THE TITLE THERETO
WITHIN (1) YEAR FROM THE DATE HEREOF.

DATED AT WATERFORD THIS 2nd DAY OF JULY 20 04

RECERTIFIED

Gary B. Foat

ZA2115-2

007-2238