


604

15

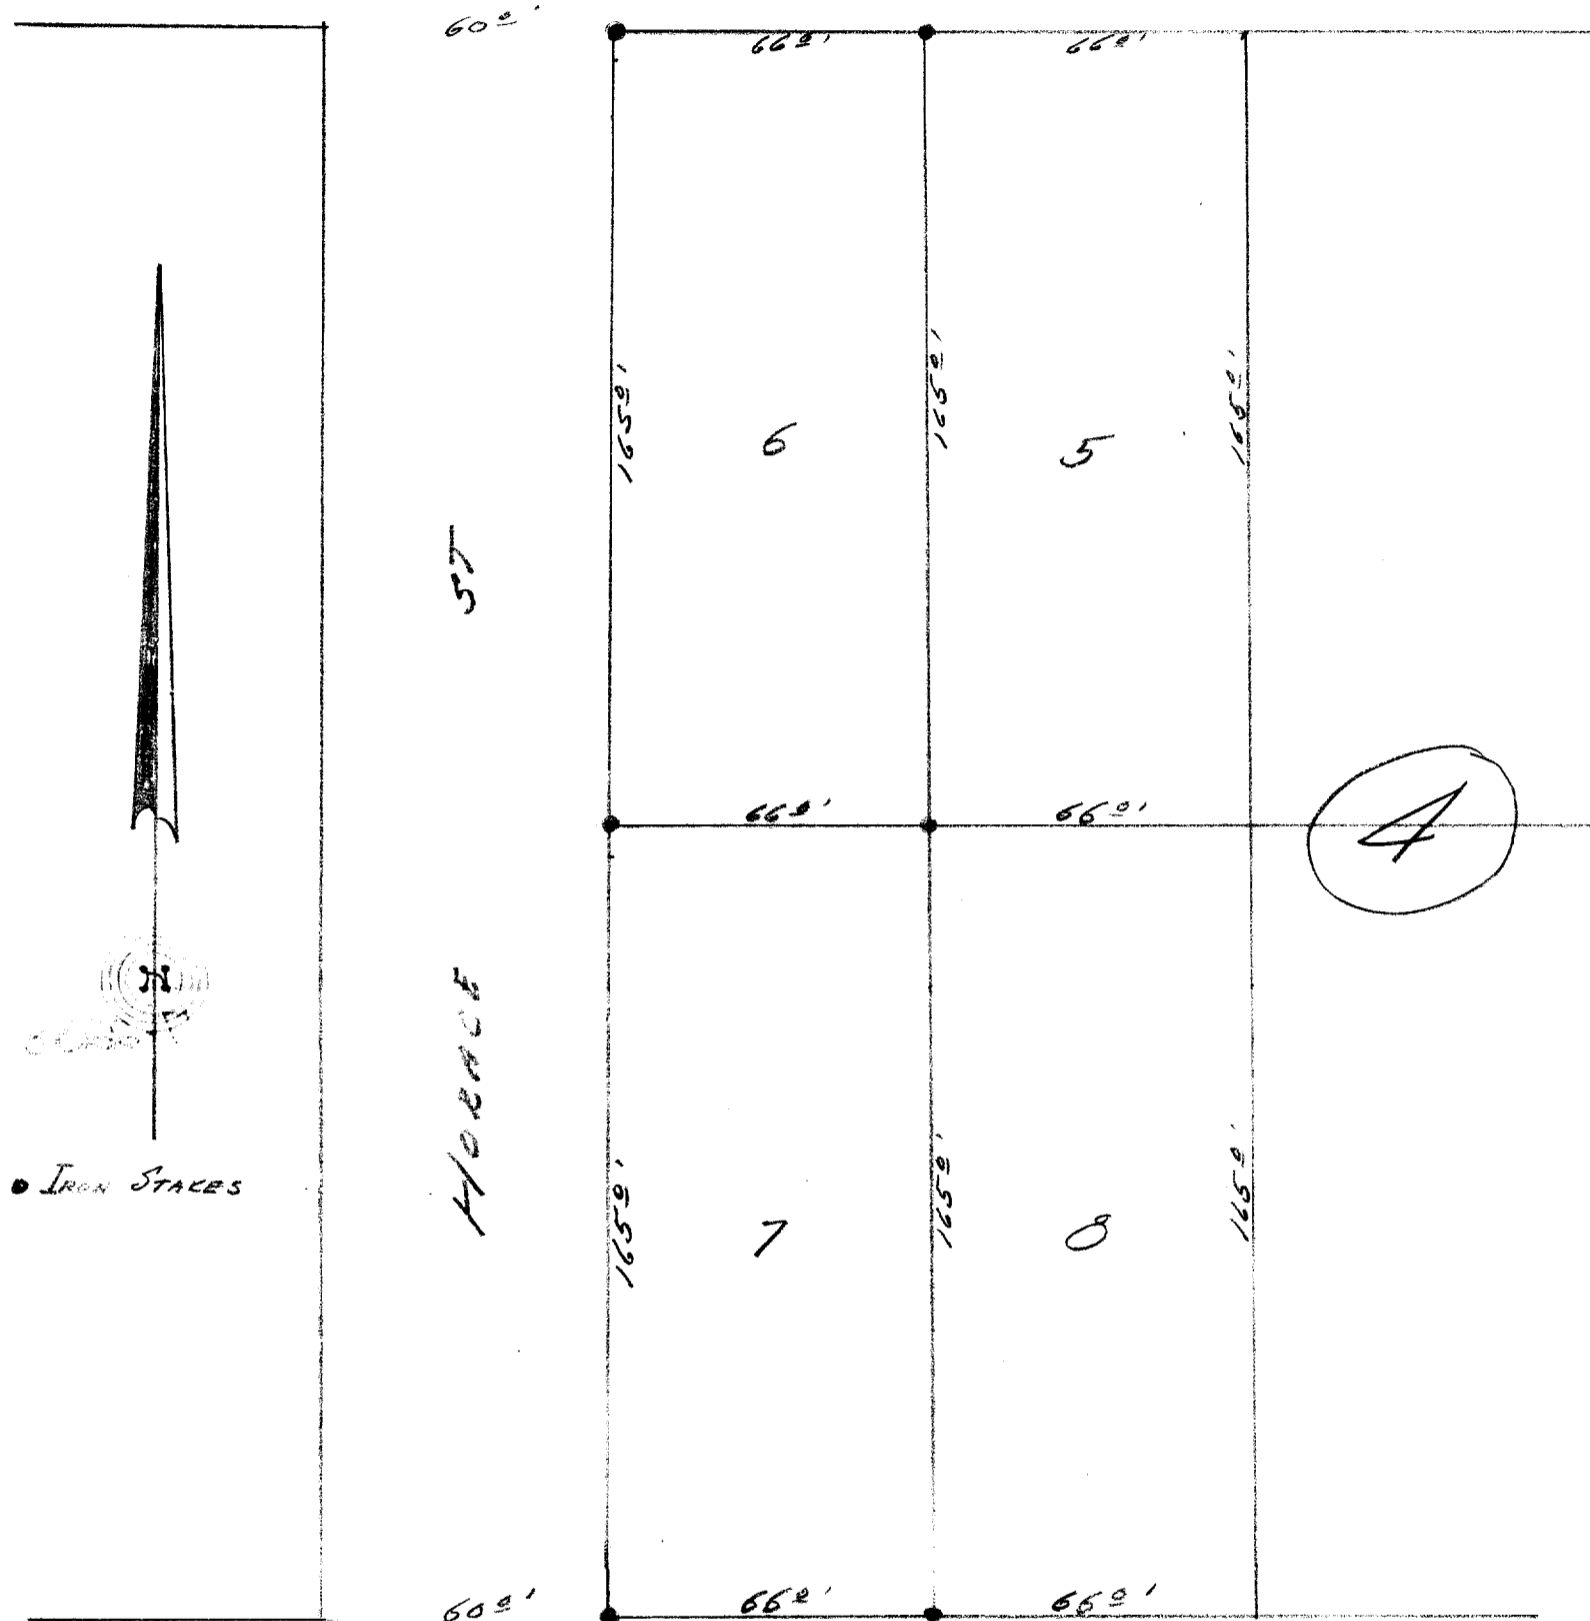

WHEELER ST.

Lot 6 and Lot 7, Block 4, Wheelers Addition to the City of Lake Geneva
Walworth County, Wisconsin.

I, hereby certify that I have on this the 18th day of June 1955, surveyed the above described property, and find that no encroachments exist.
SIGNED AND SEALED ON THIS THE 21ST DAY OF JUNE 1955.

Joseph M. Biagi. Professional Engineer.
Elkhorn Wisconsin.

2004-2005-2006

7-223B