



PREPARED FOR:
 COLDWELL BANKERS PRIMUS
 c/o LAURA RODRIGUEZ
 226 BROAD STREET
 LAKE GENEVA WI
 53147

PLAT OF SURVEY

J.K. SURVEYING INC.
 N3705 WILLOWBEND LANE
 LAKE GENEVA, WI, 53147
 262-248-3697

007-2243

- OF -
 LOTS 103 AND 104 COLUMBIAN SUBDIVISION A SUBDIVISION LOCATED
 IN THE SOUTHEAST 1/4 OF SECTION 26, AND THE SOUTHWEST 1/4 OF
 SECTION 25 TOWN 2 NORTH, RANGE 17 EAST, CITY OF LAKE GENEVA,
 WALWORTH COUNTY, WISCONSIN

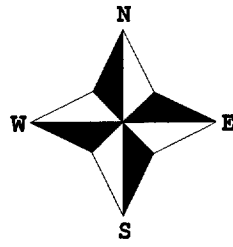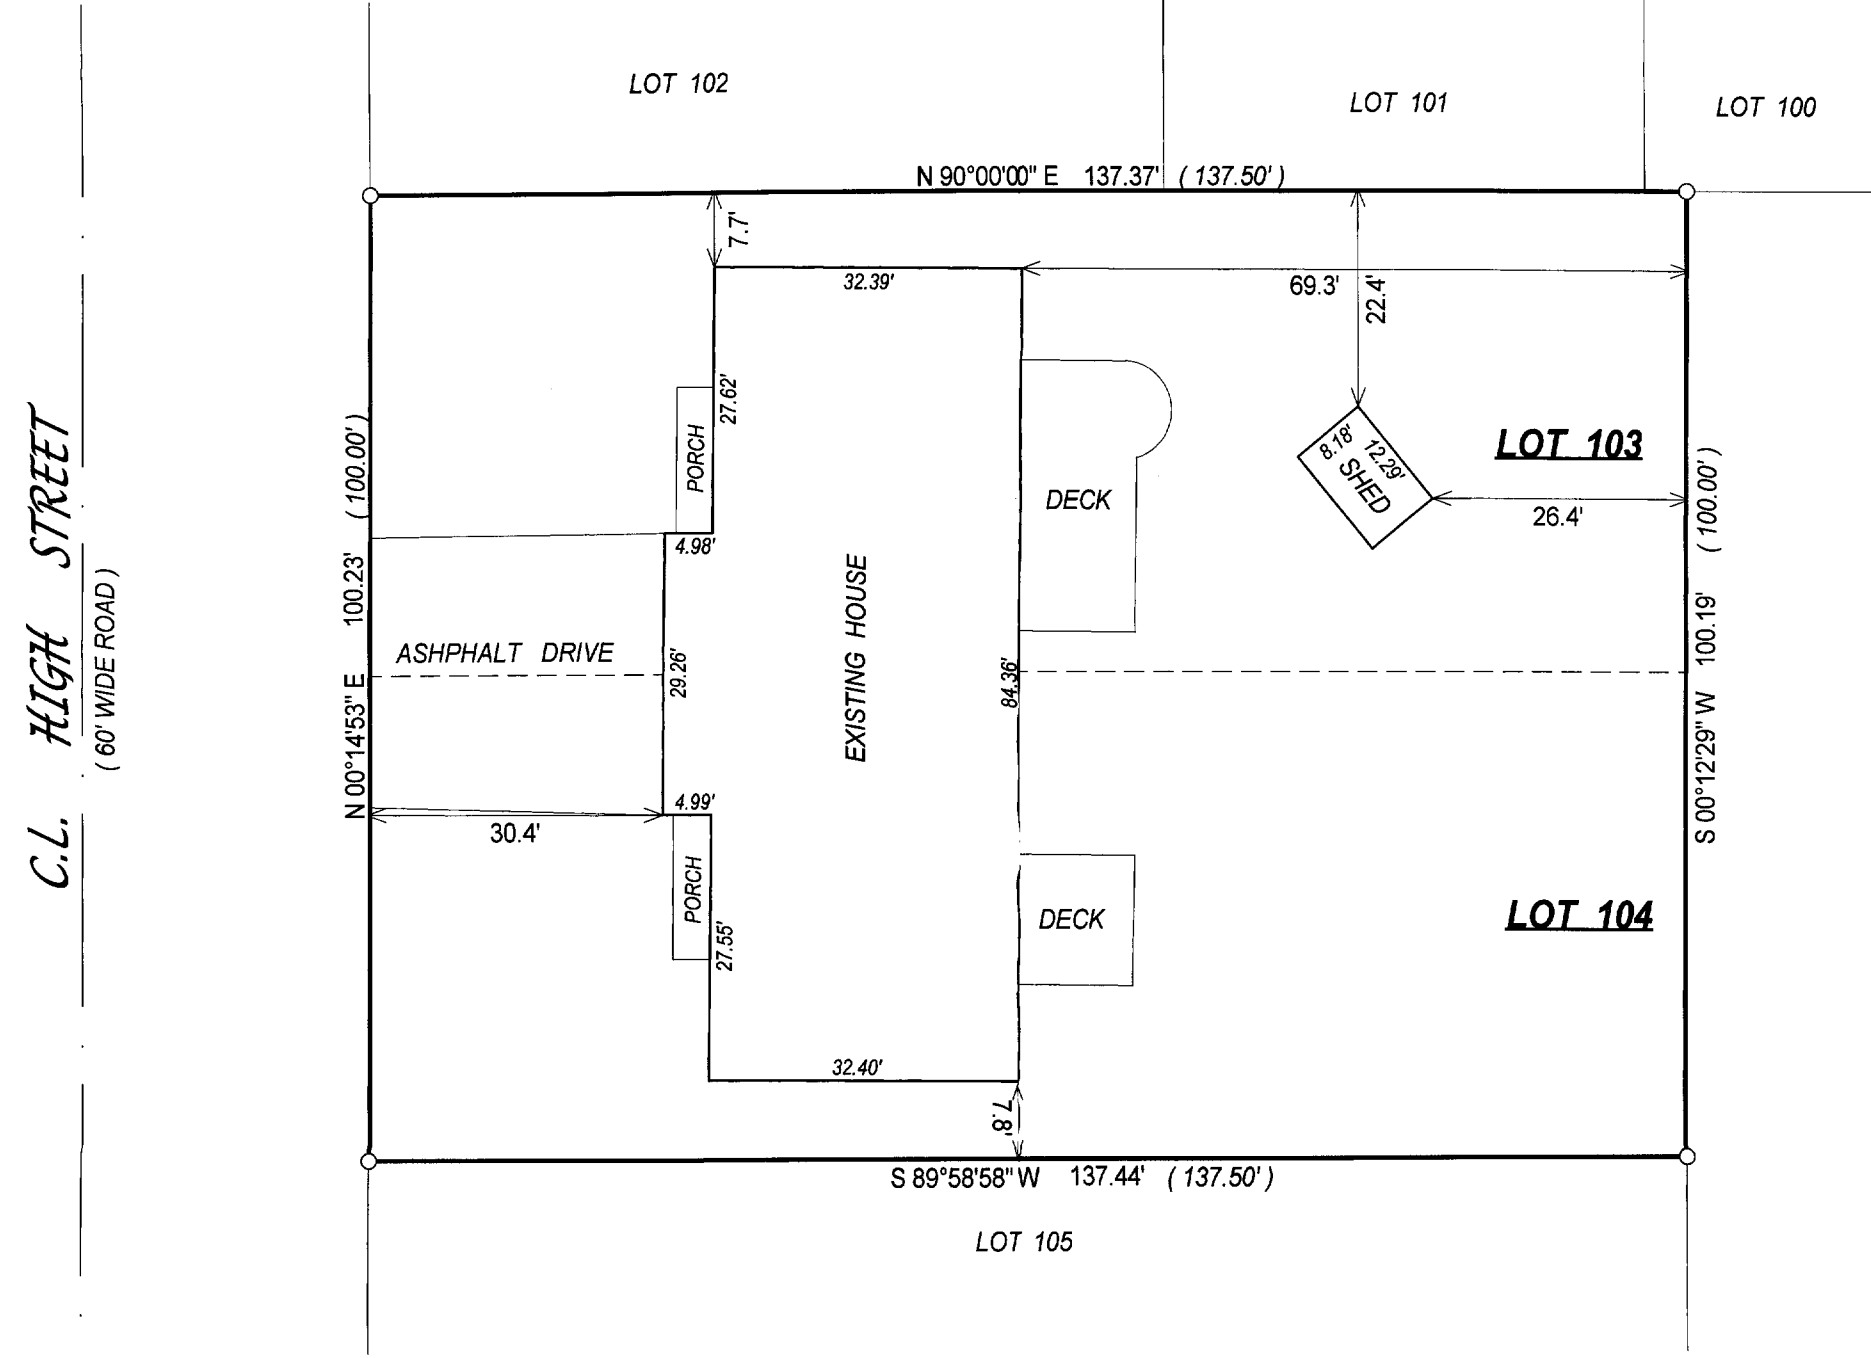

- () = recorded as
- = found iron bar
- = found iron pipe
- = set iron pipe
- = set iron bar

SCALE 1" = 20'

JOB # 04-531

TAX ID # ZCL00081

COMPARE LEGAL DESCRIPTION ABOVE AND DRAWING WITH DEED. FOR BUILDING RESTRICTIONS AND EASEMENTS NOT SHOWN, REFER TO DEED, ABSTRACT SOURCES AND LOCAL MUNICIPAL CODES. NOTIFY THE SURVEYOR IMMEDIATELY OF ANY DISCREPANCY.


"I hereby certify that I have surveyed the above described property and that the above map, to the best of my knowledge and belief, is a true representation thereof and shows the size and location of all visible structures, apparent easements and encroachments if any."
 This survey is made for the present owners of the property, and those who purchase, mortgage, or guarantee the title thereto, within one year from the date hereof.

FEB 1 3

C.L. JEFFERSON STREET
 (60' WIDE ROAD)

C.L. HIGH STREET
 (60' WIDE ROAD)

C.L. PARK ROW
 (100' WIDE ROAD)

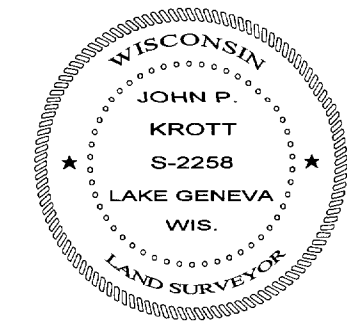

John P. Krott
 JOHN KROTT S - 2258
 Wisconsin Registered Land Surveyor
 (original if signed in red)

DATED THIS THE 12th DAY OF OCTOBER 2004.