
ENGINEERING - ARCHITECTURE - SURVEYING 7 RIDGWAY COURT - P.O. BOX 437 - ELKHORN, WISCONSIN 53121 PHONE: (262) 723-2098 FAX: (262) 723-5886

PLAT OF SURVEY

LOT 36 OF MEADOWLAND SUBDIVISION

LOCATED IN SECTION 31, TOWN 2 NORTH, RANGE 18 EAST, WALWORTH COUNTY, WISCONSIN

- WORK ORDERED BY -HOWARD BASSO - BASSO BUILDERS 405 SKYLINE DRIVE LAKE GENEVA, WI 53147

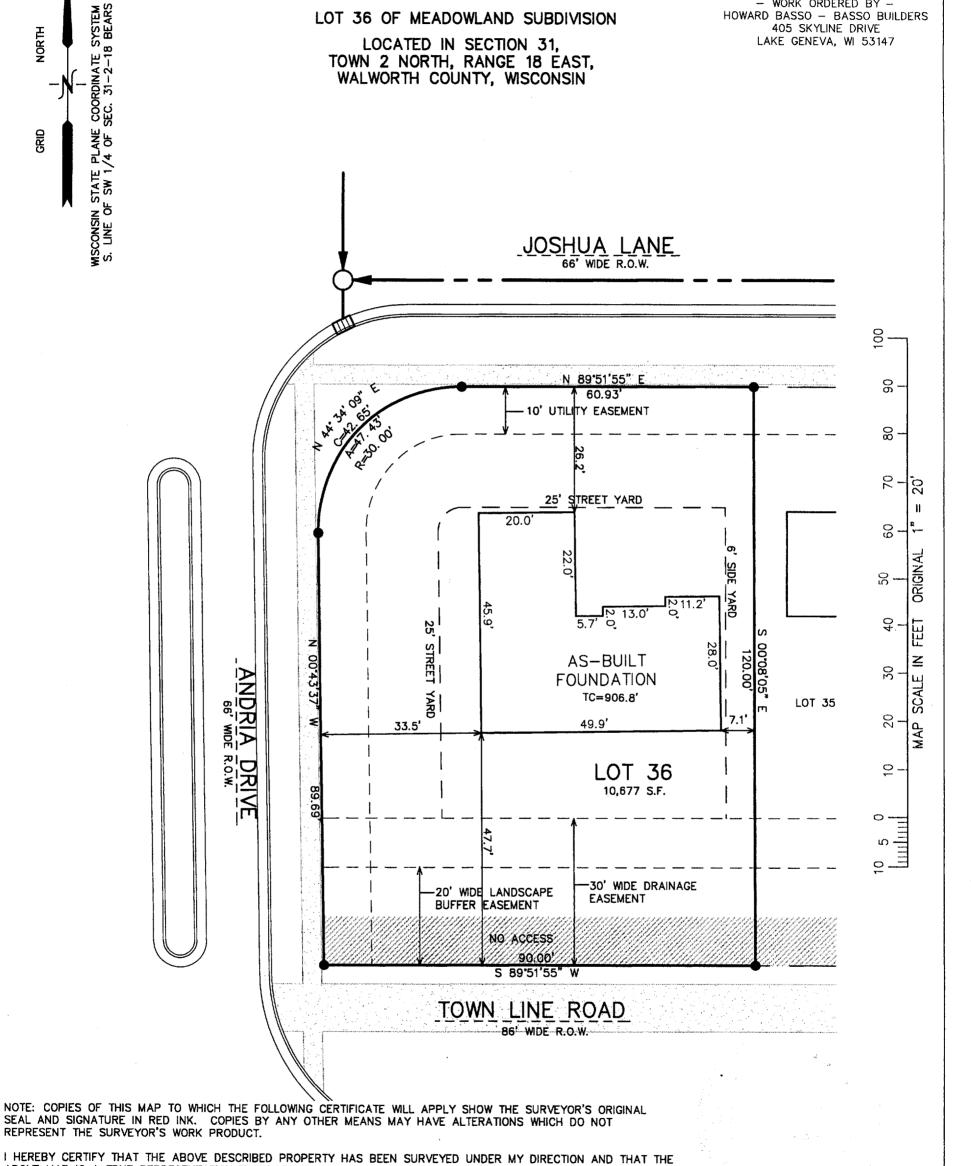

PETER S. GORDON R.L.S. 2101 ZMEA 50536

DATED: MAY 5, 2005

ABOVE MAP IS A TRUE REPRESENTATION THEREOF AND SHOWS THE SIZE AND LOCATION OF THE PROPERTY AND ITS EXTERIOR BOUNDARIES. THIS SURVEY IS MADE FOR THE USE OF THE PRESENT OWNERS OF THE PROPERTY, AND ALSO THOSE WHO PURCHASE, MORTGAGE, OR GUARANTEE THE TITLE THERETO WITHIN ONE YEAR FROM THE DATE REMSED 06/08/2005

TO SHOW SIZE & LOCATION

OF AS-BUILT FOUNDATION

SOUTH ZONE 89"51"55" W

10

NORTH

GRID

NOTE: SIDE YARD SETBACKS ARE TO BE A MINIMUM OF 6' THAT TOTAL TO 15'

(XXX) = RECORDED AS

PROJECT: 5970.36 DATE: 05/05/05 SHEET 1 OF 1

LEGEND

= FOUND IRON REBAR STAKE

007-2260