

PREPARED FOR:  
LYNN LUDKE  
GODFREY & KAHN, S.C.  
ATTORNEYS AT LAW  
780 NORTH WATER STREET  
MILWAUKEE, WI 53202-3590



# PLAT OF SURVEY

- OF -

BEGINNING AT THE NORTH 1/4 CORNER OF SECTION 1, T.1.N., R.17.E.  
OF THE 4th, P.M. CITY OF LAKE GENEVA, WALWORTH COUNTY, WISCONSIN.  
RUN THENCE SOUTH ON THE NORTH AND SOUTH 1/4 SECTION LINE 1192.62  
FEET TO A CONCRETE MONUMENT; THENCE S 89°48'27" W 107.44 FEET TO  
A POINT, SAID POINT MARKS THE PLACE OF BEGINNING OF PARCEL OF LAND  
HEREAFTER DESCRIBED; RUN THENCE S 89°48'27" W 150.00 FEET TO A POINT;  
THENCE N 00°11'35" W 70.00 FEET; THENCE N 89°48'27" E 150.00 FEET TO A  
POINT; THENCE S 00°11'35" E 70.00 FEET TO THE PLACE OF BEGINNING.

PATHFINDER SURVEYING INC.  
N3705 WILLOWBEND LANE  
LAKE GENEVA, WI, 53147  
262-248-3697

SOUTH KNOLL LANE (20') WIDE RIGHT OF WAY IN COMMON WITH OTHERS

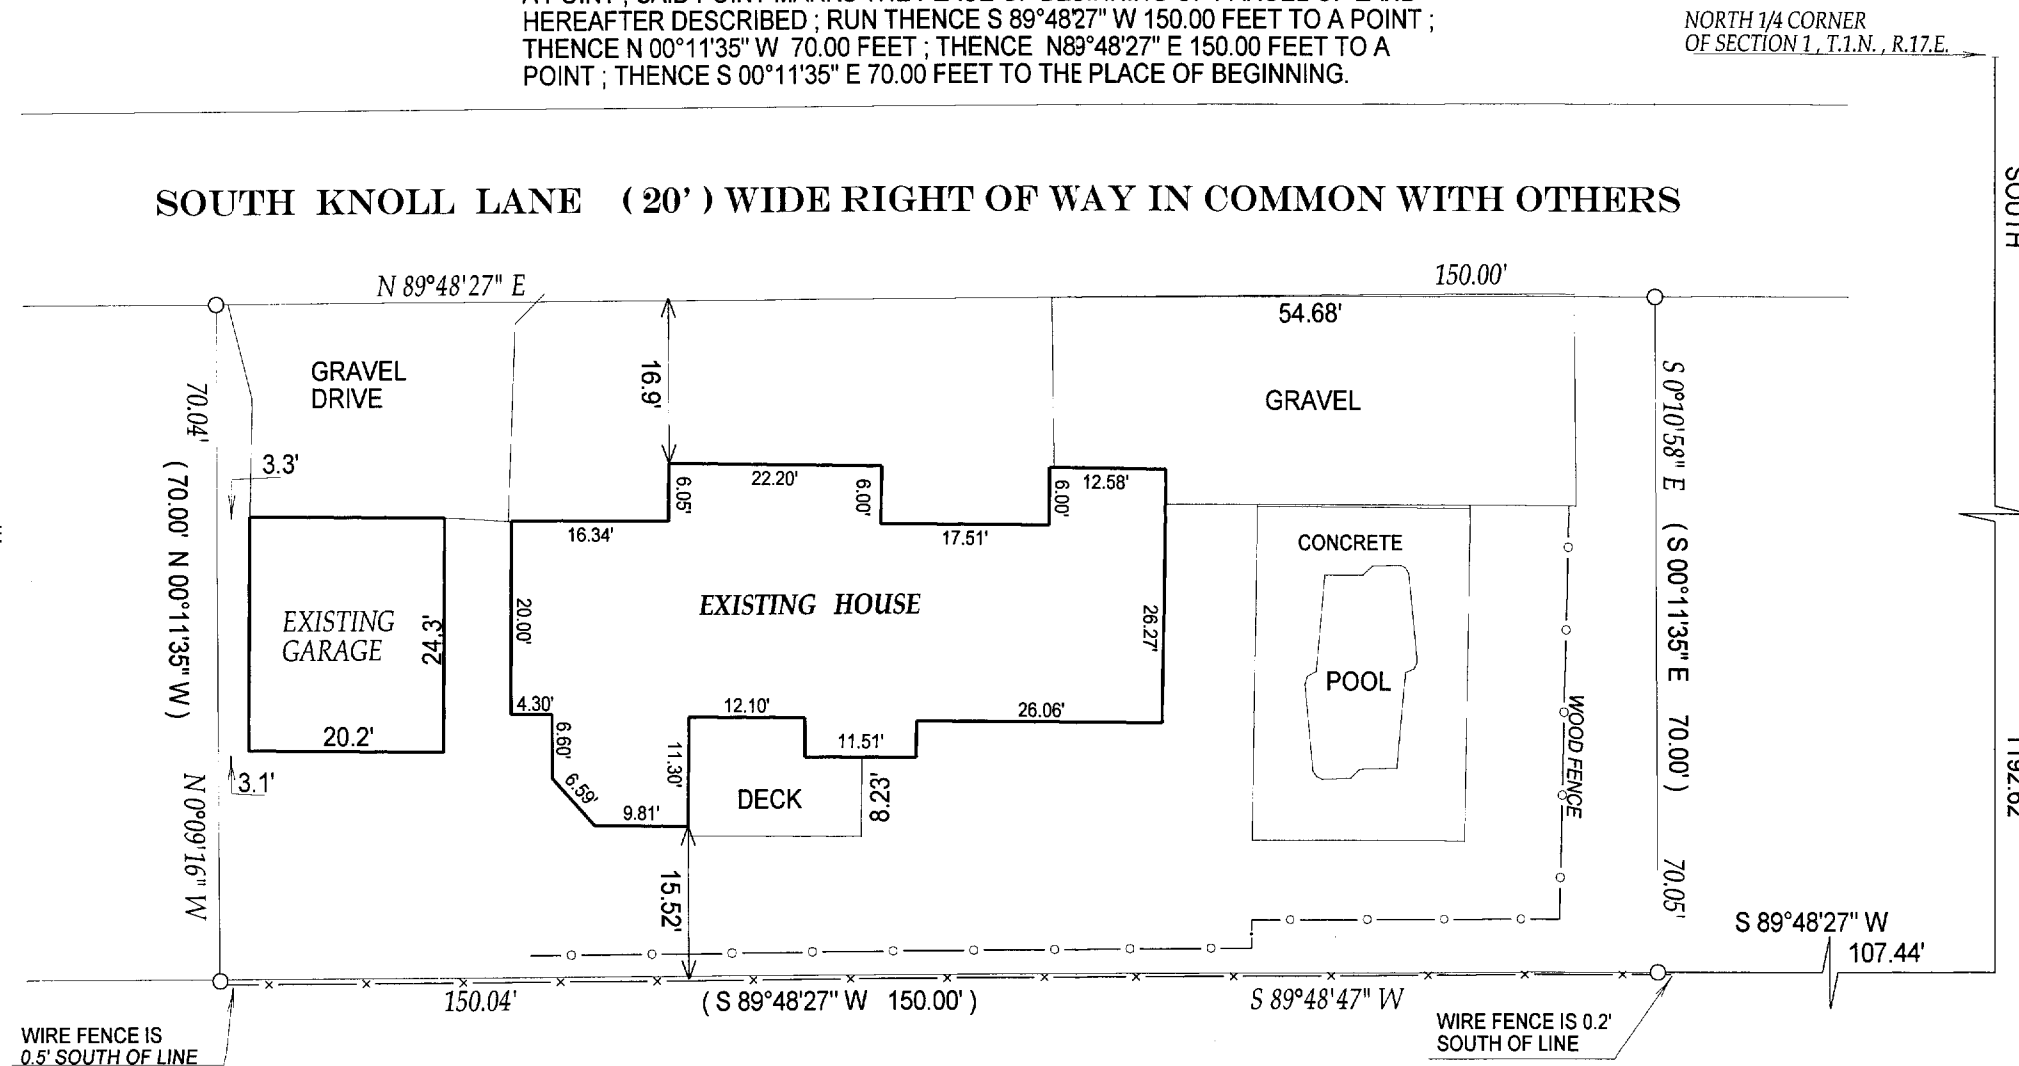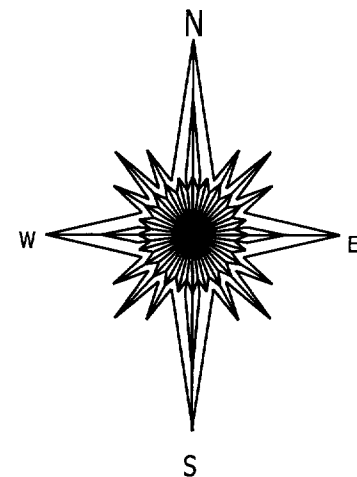

- ( ) = recorded as  
□ = found iron bar  
○ = found iron pipe  
● = set iron pipe  
■ = set iron bar

SCALE 1" = 20'



JOB # 05-446

TAX ID # ZYUP00106F

COMPARE LEGAL DESCRIPTION ABOVE AND DRAWING WITH DEED. FOR BUILDING RESTRICTIONS AND  
EASEMENTS NOT SHOWN, REFER TO DEED, ABSTRACT SOURCES AND LOCAL MUNICIPAL CODES. NOTIFY  
THE SURVEYOR IMMEDIATELY OF ANY DISCREPANCY.

"I hereby certify that I have surveyed the above described property and that  
the above map is a true representation thereof and shows the size and  
location of all visible structures, apparent easements and encroachments  
if any."  
This survey is made for the present owners of the property, and those who  
purchase, mortgage, or guarantee the title thereto, within one year from  
the date hereof.

DATED THIS 25th, DAY OF AUGUST, 2005

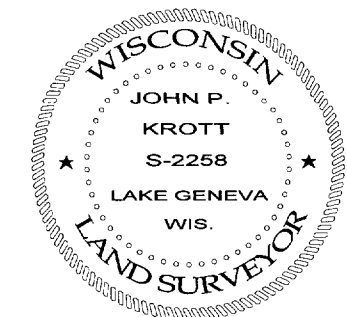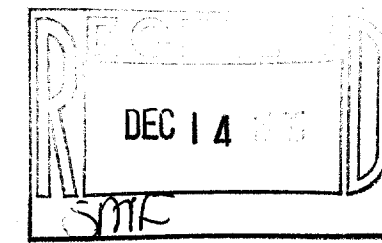

*John P. Krott*  
JOHN KROTT S - 2258  
Wisconsin Registered Land Surveyor  
(original if signed in red)

ZYUP-106F

007-2291