PREPARED FOR: JERRY POLEK KEEFE REAL ESTATE INC. 751 GENEVA PARKWAY LAKE GENEVA WI. 53147

PLAT OF SURVEY

PATHFINDER SURVEYING INC. N3705 WILLOW BEND LANE LAKE GENEVA WI. 53147

- OF -


THE NORTH 1/2 OF LOT 31 AND ALL OF LOTS 32 AND 33 OF WATSON'S BOULEVARD SUBDIVISION, LOCATED IN THE CITY OF LAKE GENEVA, WALWORTH COUNTY, WISCONSIN.

CL.

TOLMAN

ST.

(50' WIDE)

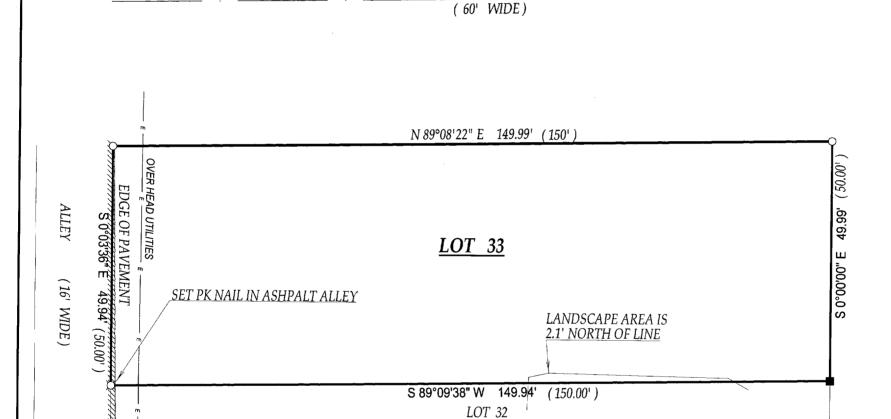

C.L. WHEELER ST.

()= recorded as

 \Box = found iron bar

= found iron pipe


= set iron pipe

= set iron bar

SCALE 1'' = 20'

JOB # 04-574SPLIT

TAX ID # ZWB00024

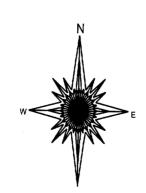


DATE OF LAST REVISION 10-26-05.

COMPARE LEGAL DESCRIPTION ABOVE AND DRAWING WITH DEED. FOR BUILDING RESTRICTIONS AND EASEMENTS NOT SHOWN, REFER TO DEED, ABSTRACT SOURCES AND LOCAL MUNICIPAL CODES. NOTIFY THE SURVEYOR IMMEDIATELY OF ANY DISCREPANCY.

"I hereby certify that I have surveyed the above described property and that the above map is a true representation thereof and shows the size and location of all visible structures, apparent easements and encroachments

This survey is made for the present owners of the property, and those who purchase, mortgage, or guarantee the title thereto, within one year from the date hereof.

DATED THIS 13th, DAY OF OCTOBER, 2004

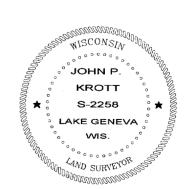

JOHN KROTT S - 2258 Wisconsin Registered Land Surveyor (original if signed in red)

007-2296