
## HAROLD H. KOLB

0

REGISTERED PROFESSIONAL LAND SURVEYOR LAKE GENEVA, WISCONSIN

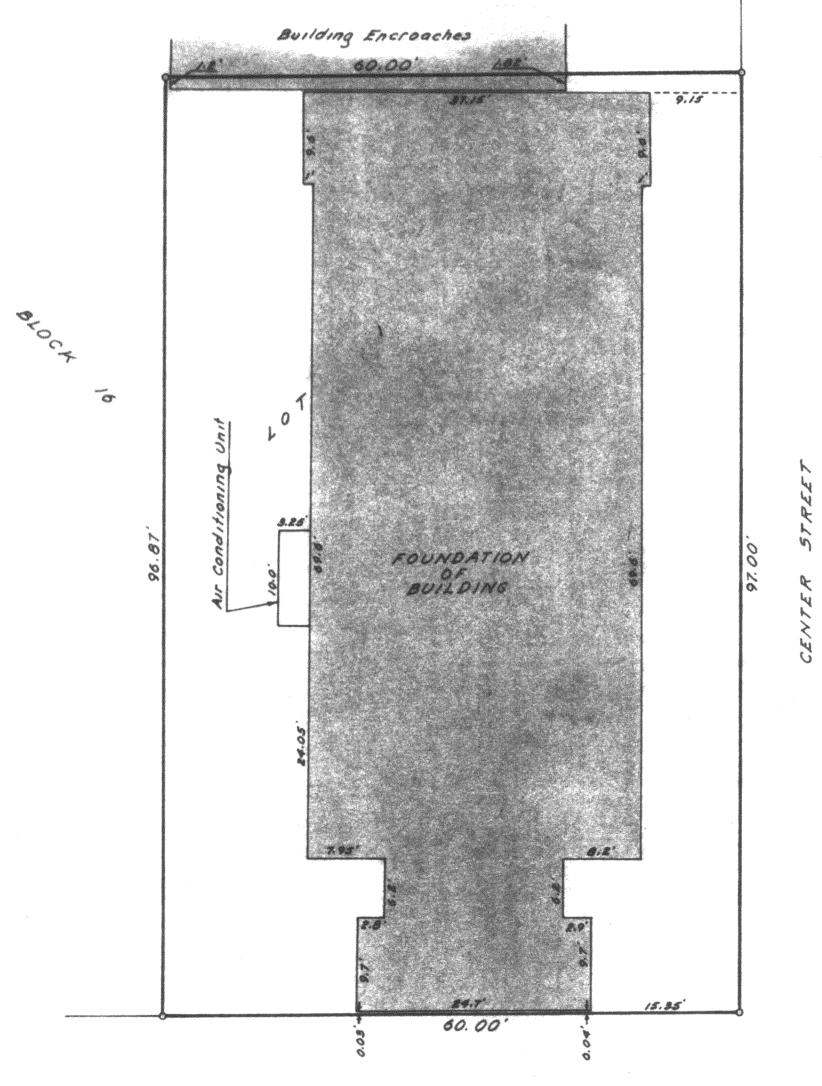

16' ALLEY

PLAT OF SURVEY OF

Part of Lot I, Block 16 of the Original Plat of the Village ( Now City ) of Lake Geneva, Walworth County, Wisconsin.



LEGEND

Ø - IRON PIPE FOUND

0 - IRON PIPE PLACED

• - CONCRETE MONUMENT

X - SPIKE

I, HAROLD H. KOLB, DO HEREBY CERTIFY THAT I HAVE SURVEYED THE PROPERTY HEREON DESCRIBED ACCORDING TO THE OFFICIAL RECORDS, AND THAT THE PLAT HEREON IS A CORRECT REPRESENTATION OF THE LOT LINES, and the principle lines of the buildings thereon.

HAROLD H. KOLB

WISCONSIN REGISTERED LAND SURVEYOR, S-187 DATE June II, 1966

200-150

7-231