
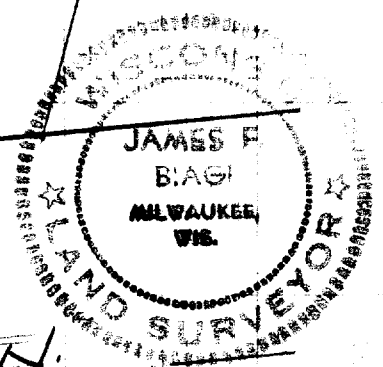


NOTE: TOTAL FRONTAGE IN PEABODY
WILL IS - 287.4
TAX ROLL - 275.2 (CALC)
TRACT INDEX - 267.10

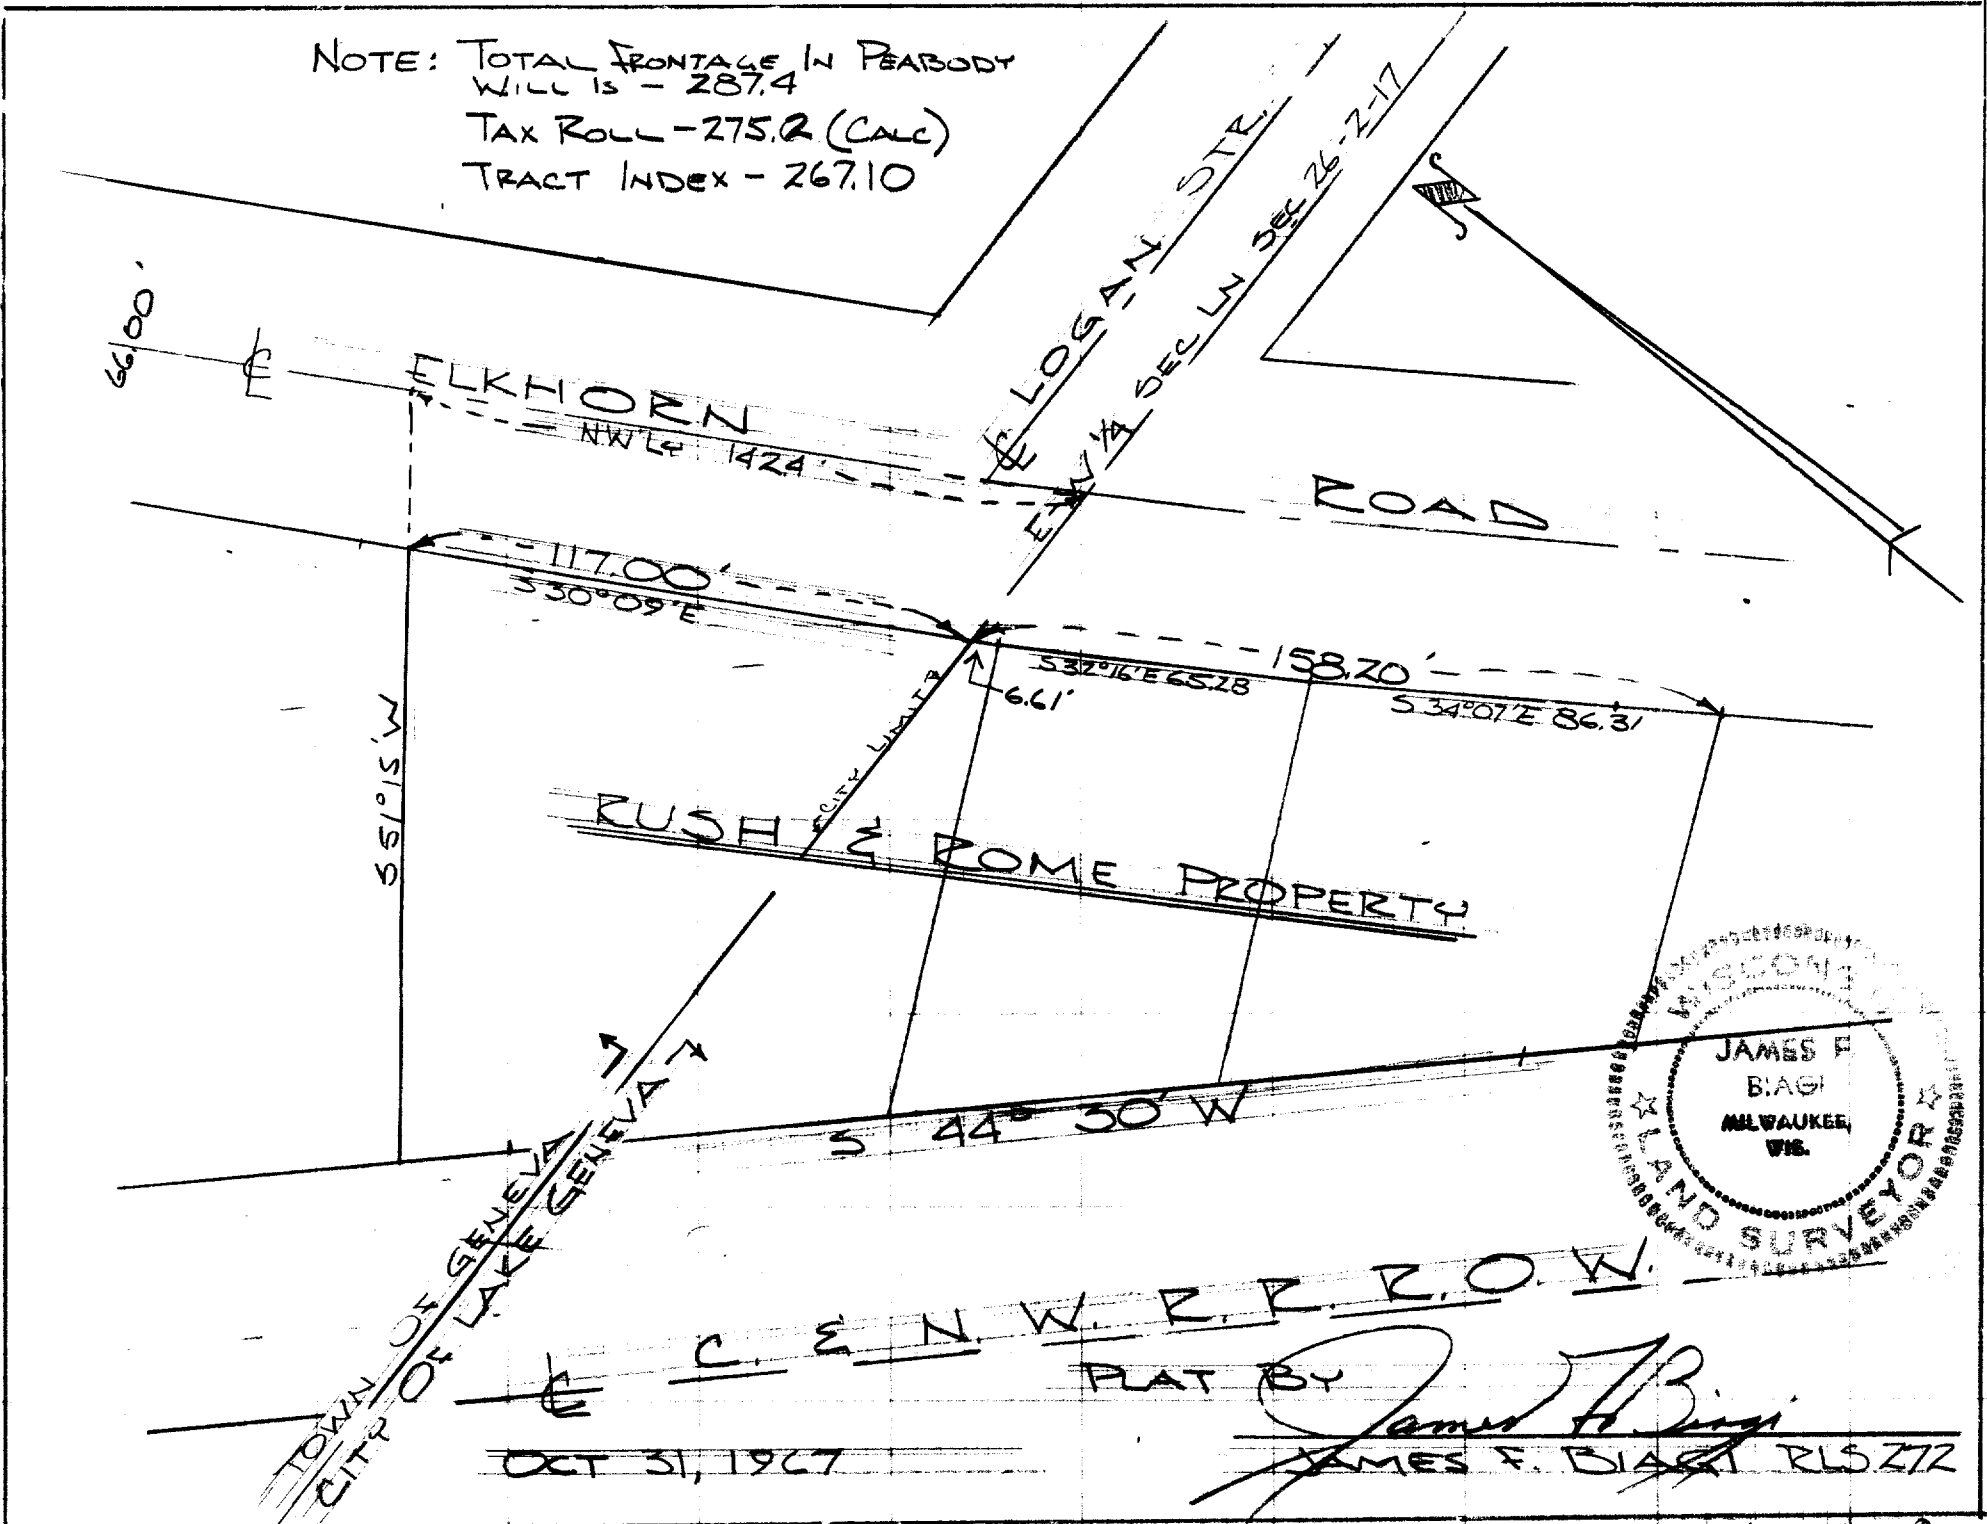

PLAT BY
James F. Biagi
 JAMES F. BIAGI RLS 272
 OCT 31, 1967

UP - 44A (part of)

17-231B

170-67