


DEGEN-FOAT SURVEYING LLC
100 SOUTH SECOND STREET
WATERFORD, WISCONSIN
(262)534-5404 (FAX)534-2022

059158
059158\$1.DWG

PLAT OF SURVEY

LOT 2 OF CERTIFIED SURVEY MAP NO. 2115, RECORDED IN VOLUME 10 PAGE 119, BEING
LOCATED IN THE NORTHEAST 1/4 OF THE NORTHWEST 1/4 OF SECTION 36, TOWN 2 NORTH,
RANGE 17 EAST, CITY OF LAKE GENEVA, WALWORTH COUNTY, WISCONSIN.


PREPARED FOR: DEBORAH NELSON
1310 DODGE STREET
LAKE GENEVA, WI 53147

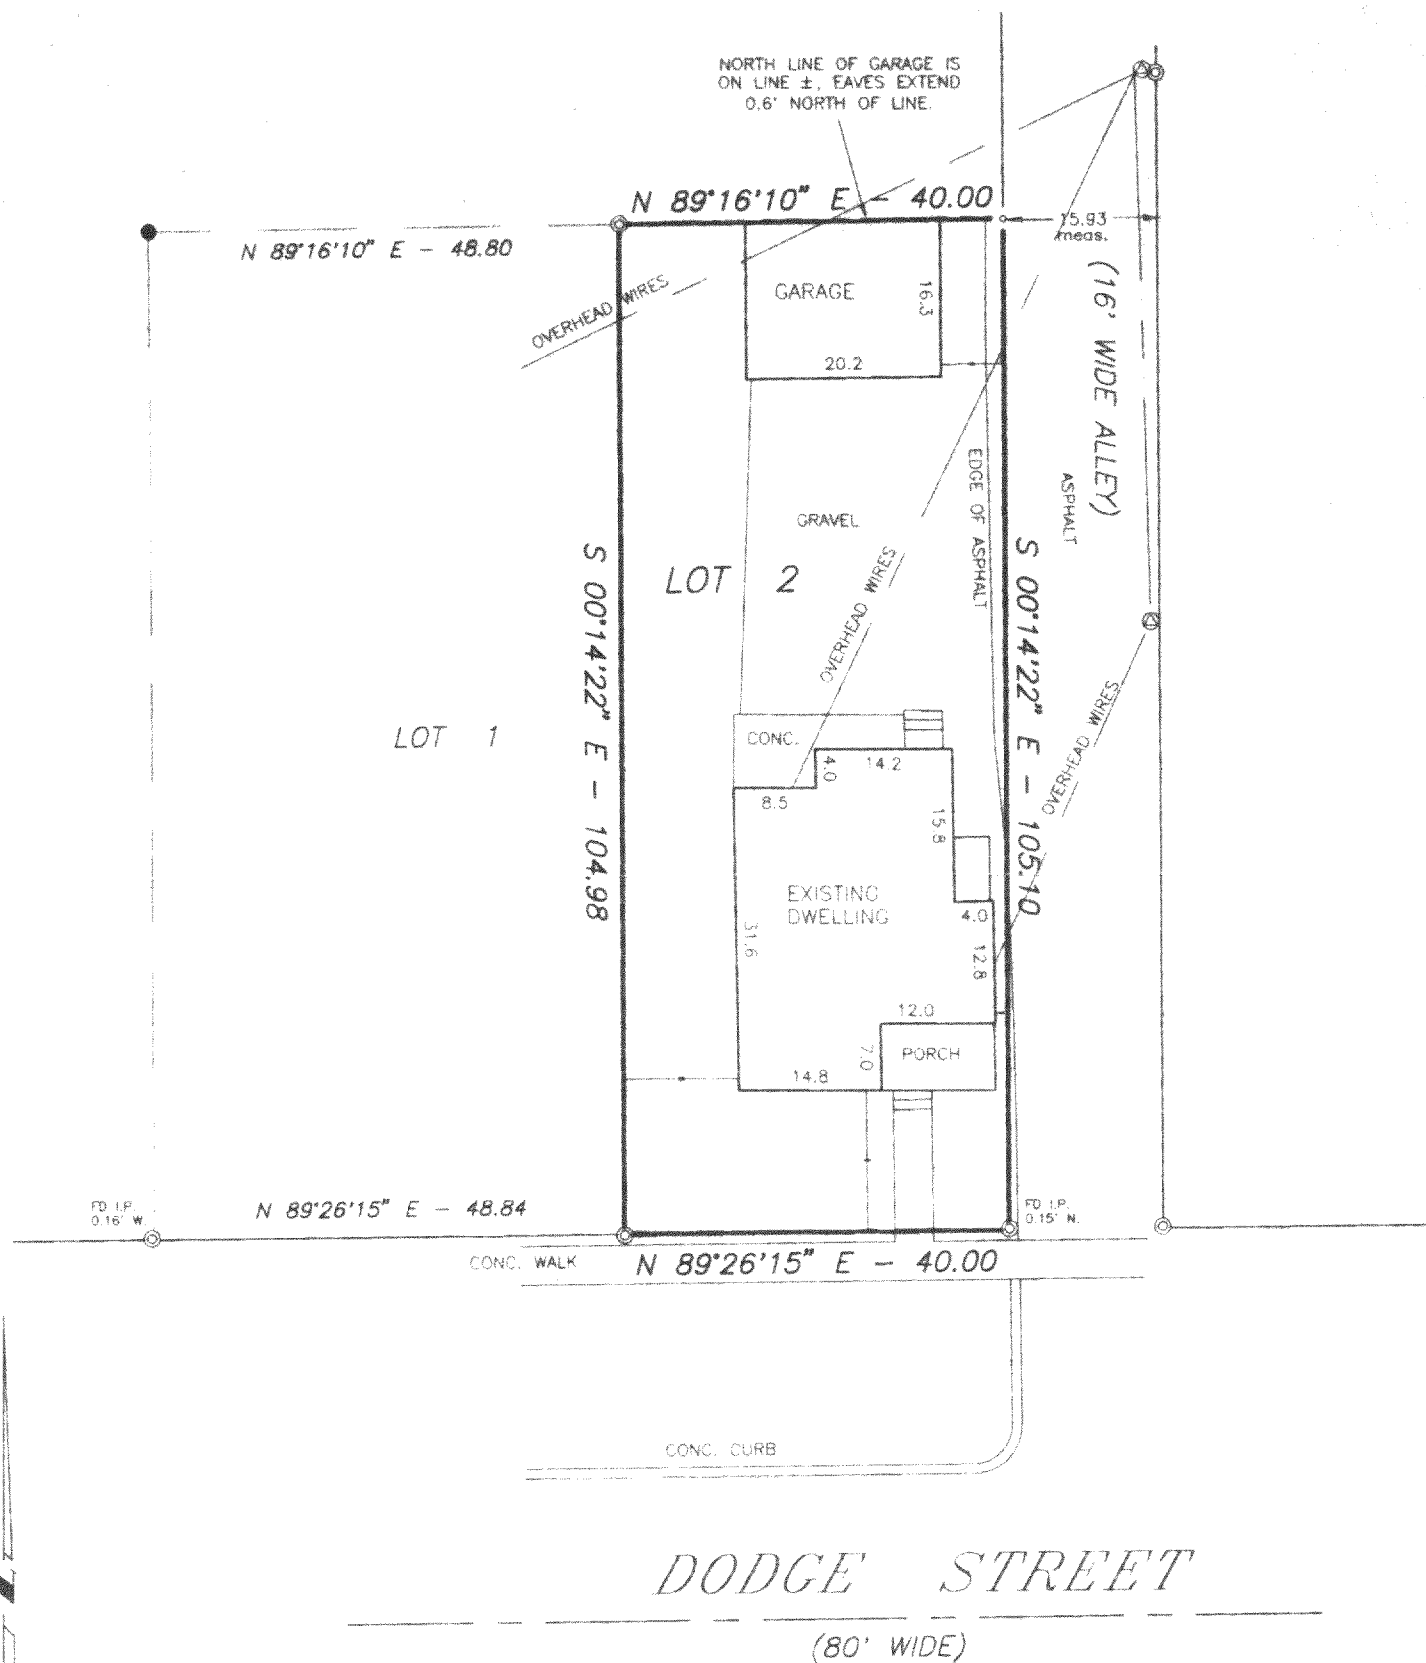

LEGEND

- - FOUND 60d NAIL
- ⊙ - FOUND IRON PIPE
- - FOUND IRON ROD
- - SET IRON PIPE
- () - RECORDED AS
- ⊗ - UTILITY POLE

SCALE: 1" = 20'
BEARING BASE: AS RECORDED AS

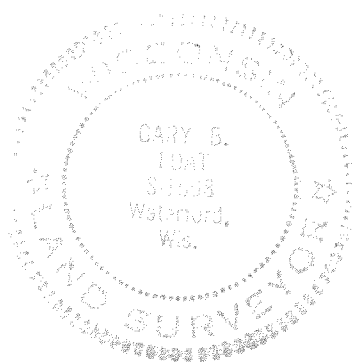


I HEREBY CERTIFY THAT I HAVE SURVEYED THE ABOVE DESCRIBED PROPERTY AND THE ABOVE MAP IS A TRUE REPRESENTATION THEREOF
AND SHOWS THE SIZE AND LOCATION OF THE PROPERTY, THE LOCATION OF ALL VISIBLE STRUCTURES AND DIMENSIONS OF ALL PRINCIPAL
BUILDINGS THEREON, BOUNDARY FENCES, APPARENT EASEMENTS, ROADWAY AND VISIBLE ENCROACHMENTS, IF ANY

THIS SURVEY IS MADE FOR THE PRESENT OWNERS OF THE PROPERTY, AND ALSO THOSE WHO PURCHASE, OR GUARANTEE THE TITLE THERETO
WITHIN (1) YEAR FROM THE DATE HEREOF

DATED AT WATERFORD THIS 31ST DAY OF MAY 2005

RECERTIFIED

Gary S. Foot

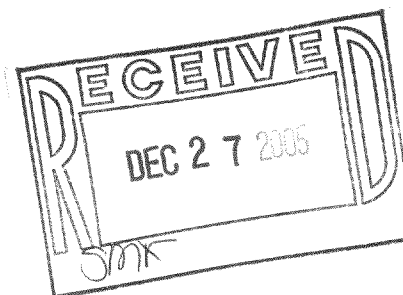

ZA2115-2

007-2374