


# PLAT OF SURVEY

- OF -


A PARCEL OF LAND LOCATED IN THE SOUTHWEST 1/4 OF THE NORTHWEST 1/4, SECTION 31, TOWN 2 NORTH, RANGE 18 EAST, WALWORTH COUNTY, WISCONSIN. DESCRIBED AS FOLLOWS COMMENCING AT THE WEST 1/4 CORNER OF SAID SECTION 31; THENCE NORTH 705.32 FEET TO THE SOUTH LINE OF STATE HIGHWAY NO. 50; THENCE NORTH 79°42'35" EAST, 135.51 FEET THENCE NORTH 78°23'15" EAST, 372.86 FEET TO THE PLACE OF BEGINNING; THENCE NORTH 00°08'00" WEST 33.67 FEET TO THE CENTERLINE OF SAID HIGHWAY; THENCE NORTH 78°23'15" EAST 302.00 FEET; THENCE SOUTH 00°08'20" E 348.94 FEET; THENCE SOUTH 89°51'55" WEST 295.65 FEET; THENCE NORTH 00°08'20" WEST 255.32 FEET TO THE POINT OF BEGINNING.

ALSO: LOT 1 OF CERTIFIED SURVEY MAP NO. 917 LOCATED IN THE NORTHWEST 1/4 OF SECTION 31 TOWN 2 NORTH, RANGE 18 EAST, WALWORTH COUNTY, WISCONSIN.

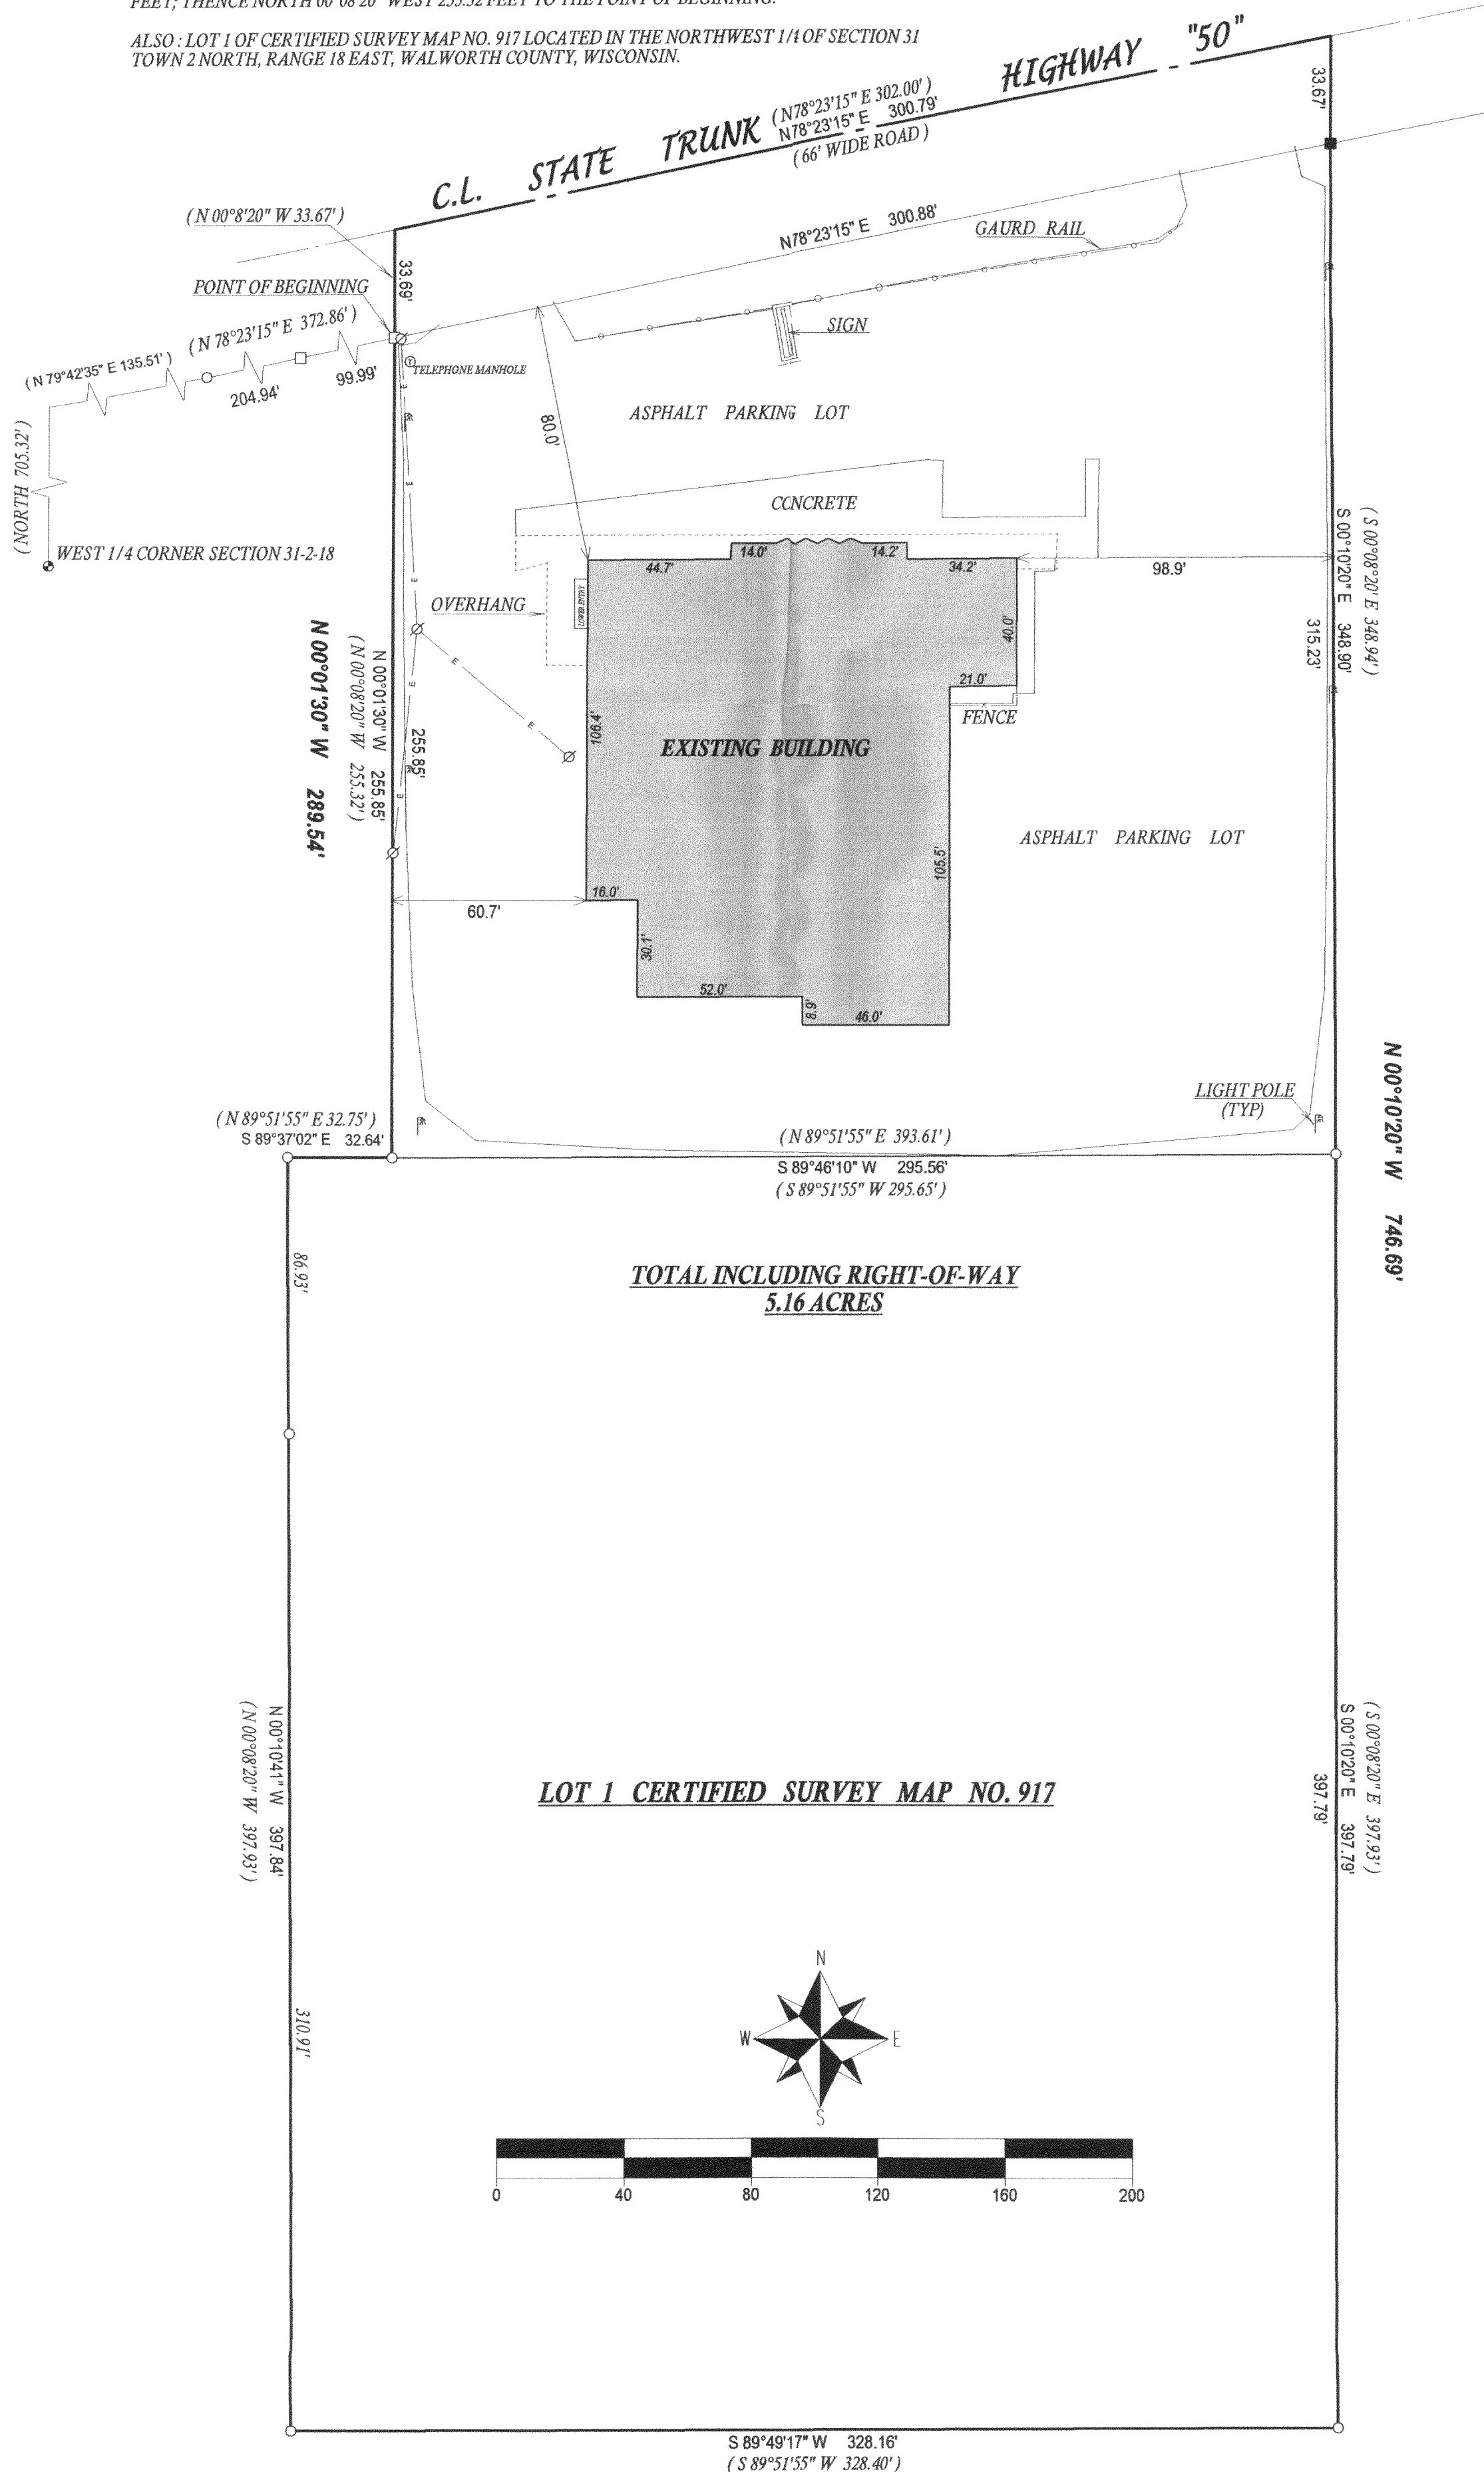

**TOTAL INCLUDING RIGHT-OF-WAY  
 5.16 ACRES**

**LOT 1 CERTIFIED SURVEY MAP NO. 917**

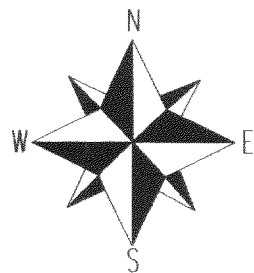

S 89°49'17" W 328.16'  
 (S 89°51'55" W 328.40')

- ( ) = recorded as
- = found iron bar
- = found iron pipe
- = set iron pipe
- = set iron bar

SCALE 1" = 40'

JOB # 06-129

TAX ID # ZYUP00107 & NA91700001

COMPARE LEGAL DESCRIPTION ABOVE AND DRAWING WITH DEED. FOR BUILDING RESTRICTIONS AND EASEMENTS NOT SHOWN, REFER TO DEED, ABSTRACT SOURCES AND LOCAL MUNICIPAL CODES. NOTIFY THE SURVEYOR IMMEDIATELY OF ANY DISCREPANCY.

"I hereby certify that I have surveyed the above described property and that the above map, to the best of my knowledge and belief, is a true representation thereof and shows the size and location of all visible structures, apparent easements and encroachments if any."  
 This survey is made for the present owners of the property, and those who purchase, mortgage, or guarantee the title thereto, within one year from the date hereof.

MAY 4 2006  
 SMF



John P. Krott  
 JOHN KROTT S - 2258  
 Wisconsin Registered Land Surveyor  
 (original if signed in red)

DATED THIS THE 10th DAY OF APRIL 2006.

007-2/05