


REGISTERED PROFESSIONAL LAND SURVEYOR
LAKE GENEVA, WISCONSIN



Q - IRON PIPE FOUND
O - IRON PIPE PLACED
● - CONCRETE MONUMENT
X - SPIKE

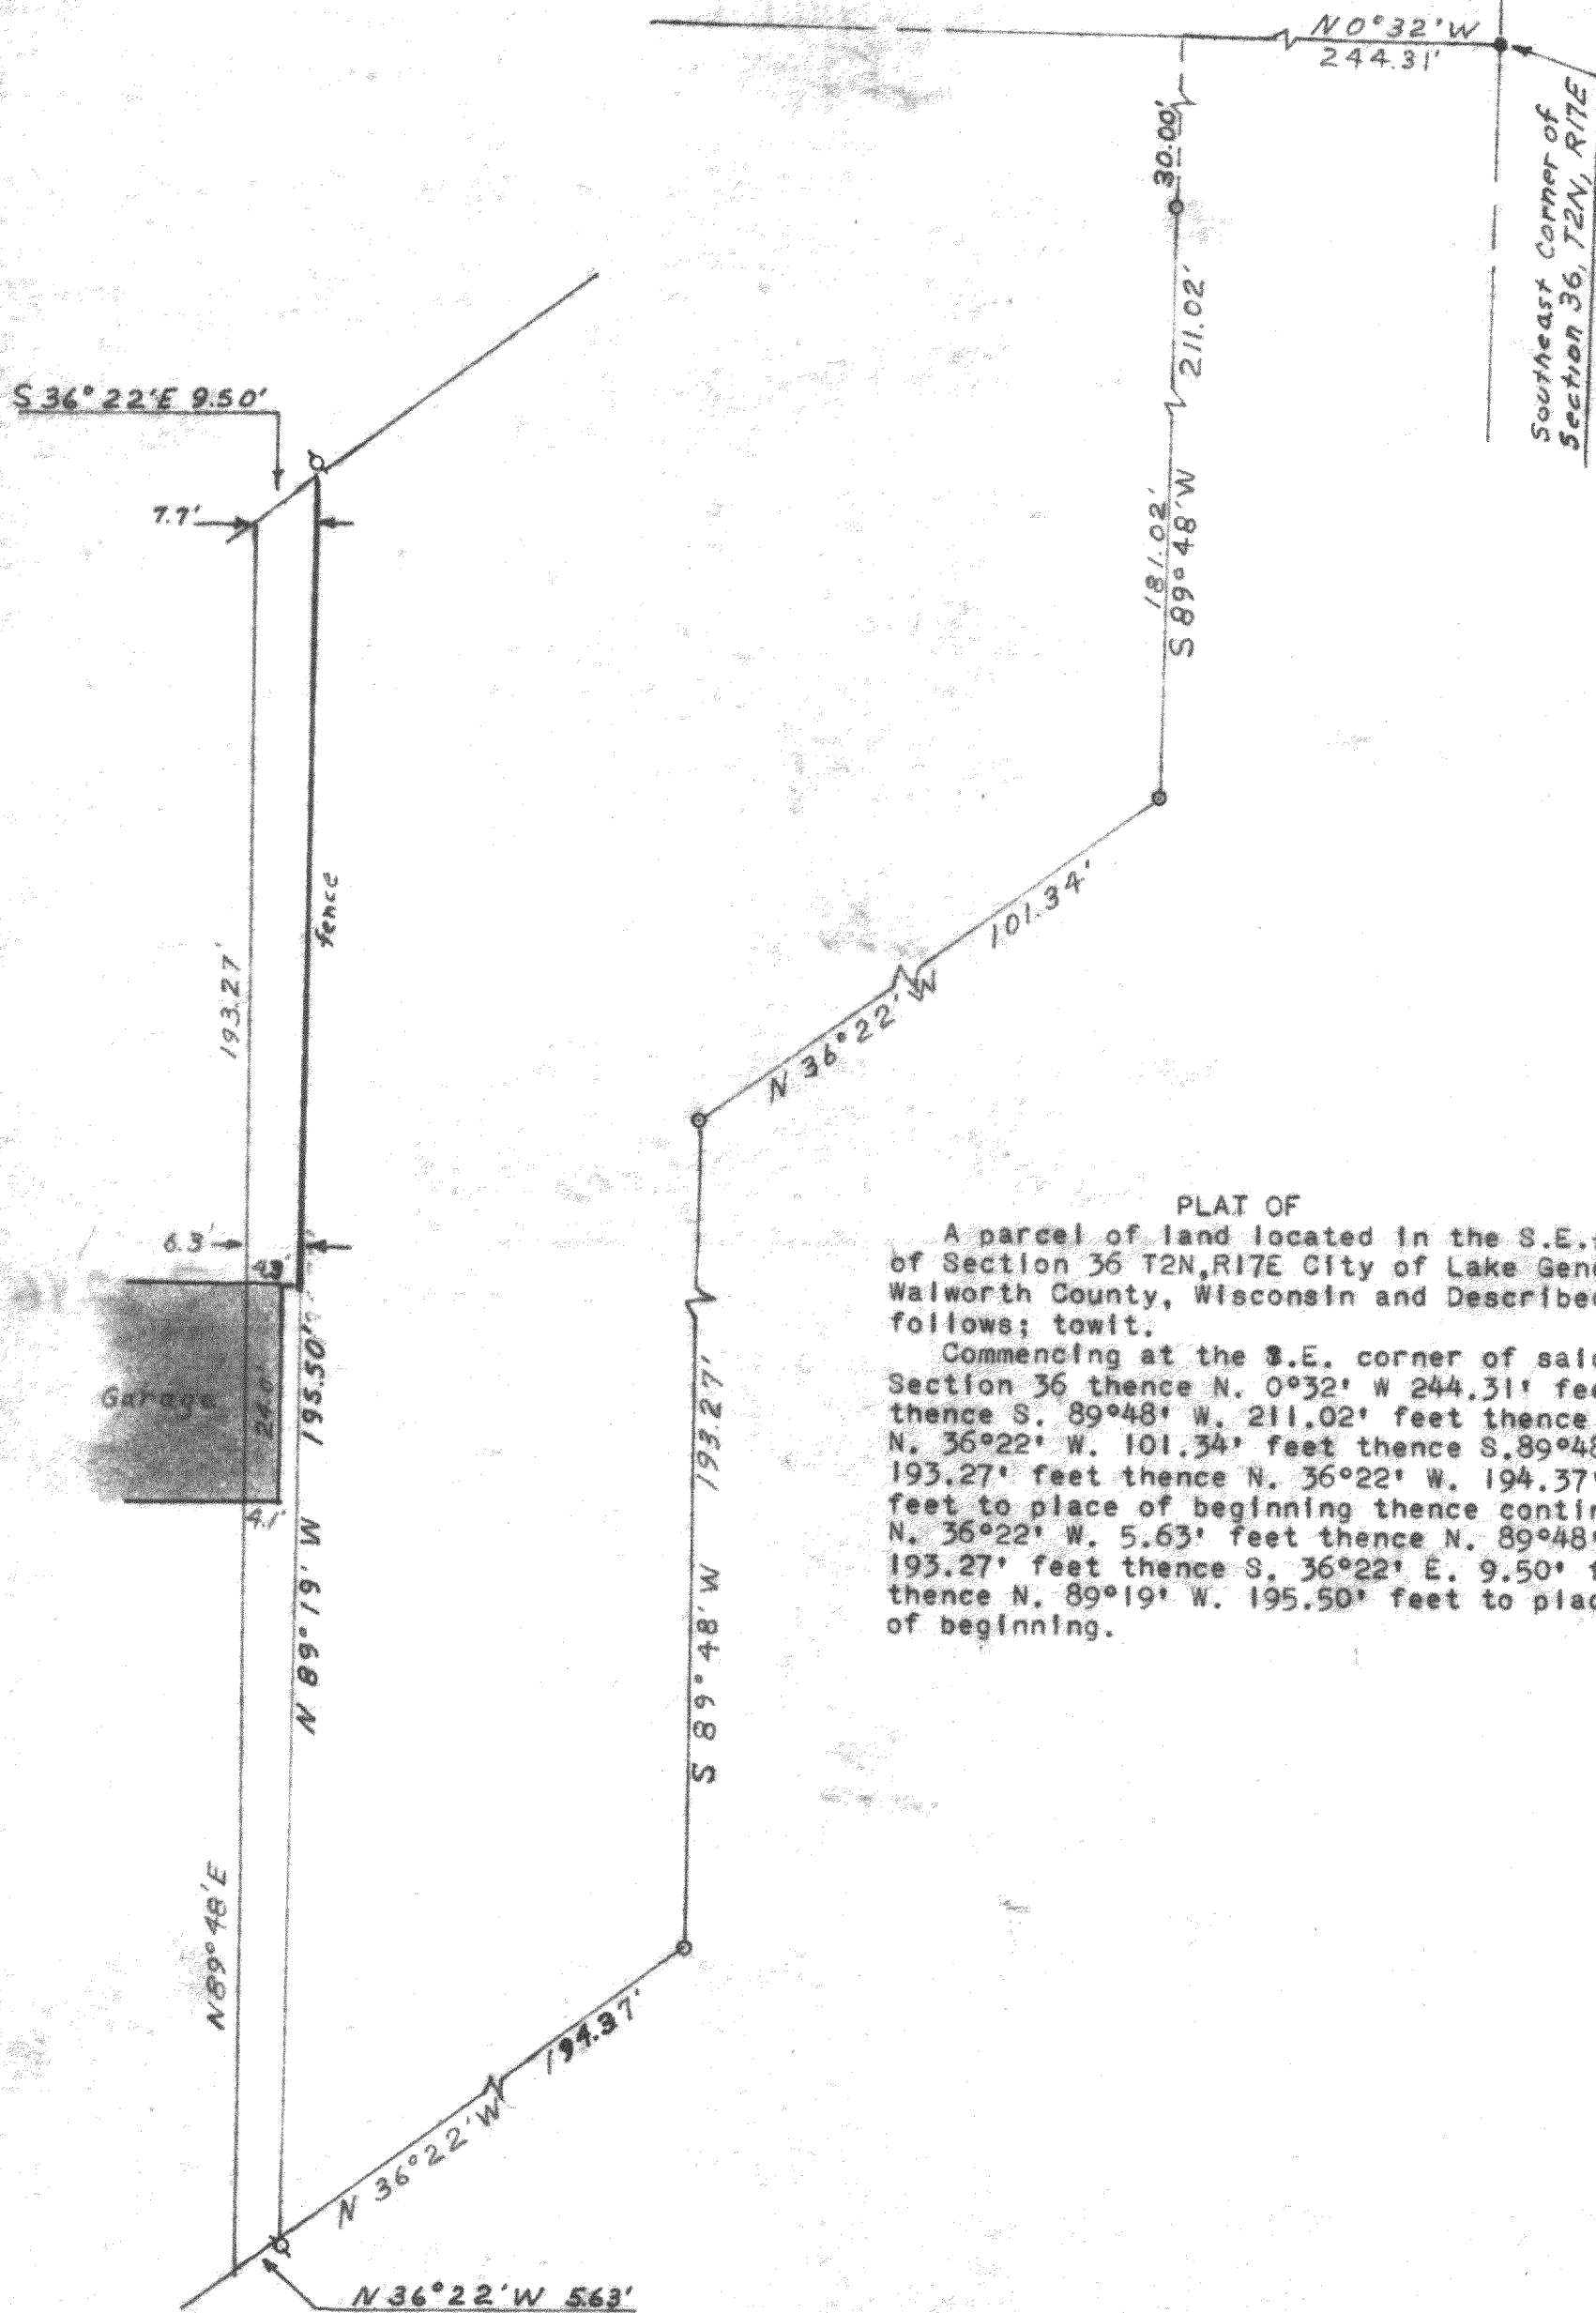

SCALE 1"=20'

I, HAROLD H. KOLB, DO HEREBY CERTIFY THAT I HAVE SURVEYED THE PROPERTY HEREON DESCRIBED ACCORDING TO THE OFFICIAL RECORDS, AND THAT THE PLAT HEREON IS A CORRECT REPRESENTATION OF THE LOT LINES.

Harold H. Kolb
HAROLD H. KOLB
WISCONSIN REGISTERED LAND SURVEYOR, S-187
DATE DECEMBER 21, 1966

7-246

OP-399B (fence line)