

## HAROLD H. KOLB

REGISTERED PROFESSIONAL LAND SURVEYOR LAKE GENEVA, WISCONSIN

ANN STREET

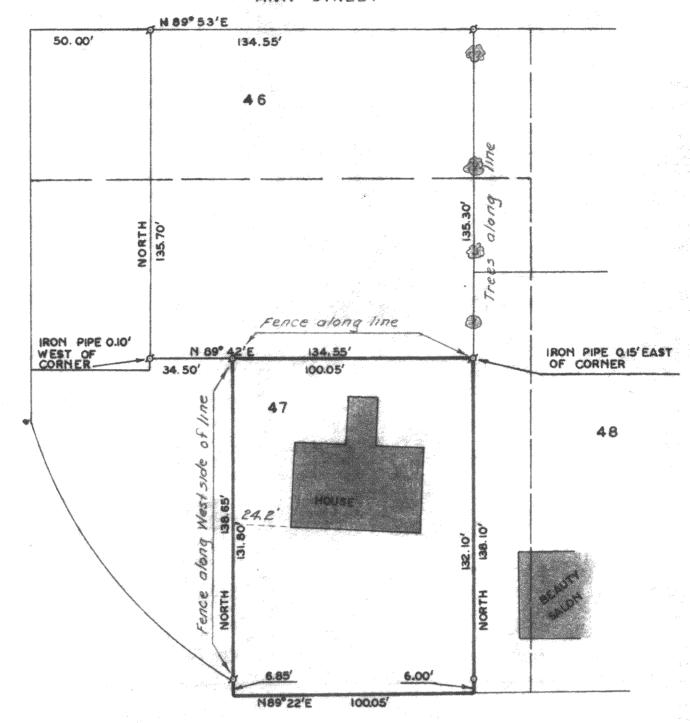

NORTH STREET

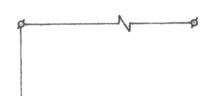

PLAT OF SURVEY OF
A parcel of land located in Lot 47, Ferguson's Addition to the
Village, now City, of Lake Geneva, Walworth County, Wisconsin
and described as follows; towit: Commencing at the Northwest
corner of Lot 46, said Ferguson's Addition; thence N 89°53' E
50 feet; thence South 135.70 feet; thence N 89°42' E 34.50
feet to the place of beginning; thence continue N 89°42' E
100.05 feet; thence South 138.10 feet; thence S 89°22' W
100.05 feet; thence north 138.65 feet to the place of
beginning.



SCALE: I"=40'

Ø - IRON PIPE FOUND

O - IRON PIPE PLACED

O - CONCRETE MONUMENT

X - SPIKI

I, HAROLD H. KOLB, DO HEREBY CERTIFY THAT I HAVE SURVEYED THE PROPERTY HEREON DESCRIBED ACCORDING TO THE OFFICIAL RECORDS, AND THAT THE PLAT HEREON IS A CORRECT REPRESENTATION OF THE LOT LINES, and the principle lines of the buildings thereon.

Harold A. X.

HAROLD H. KOLB

WISCONSIN REGISTERED LAND SURVEYOR, S-187 DATE January 9, 1967

BT C & 1118

STREET

WILLIAMS

7-248