
PREPARED FOR VIRGINIA JEDDA 1443 LASALLE ST. LAKE GENEVA WI. 53147

## PLAT OF SURVEY

PATHFINDER SURVEYING INC. W2888 KRUEGER RD. UNIT "D" LAKE GENEVA WI. 53147 (262) 248-3697

LOT 2 CERTIFIED SURVEY MAP NO. 1042 LOCATED IN THE SOUTHEAST 1/4 OF SECTION 26, TOWN 2 NORTH, RANGE 17 EAST, CITY OF LAKE GENEVA, WALWORTH COUNTY, WISCONSIN.

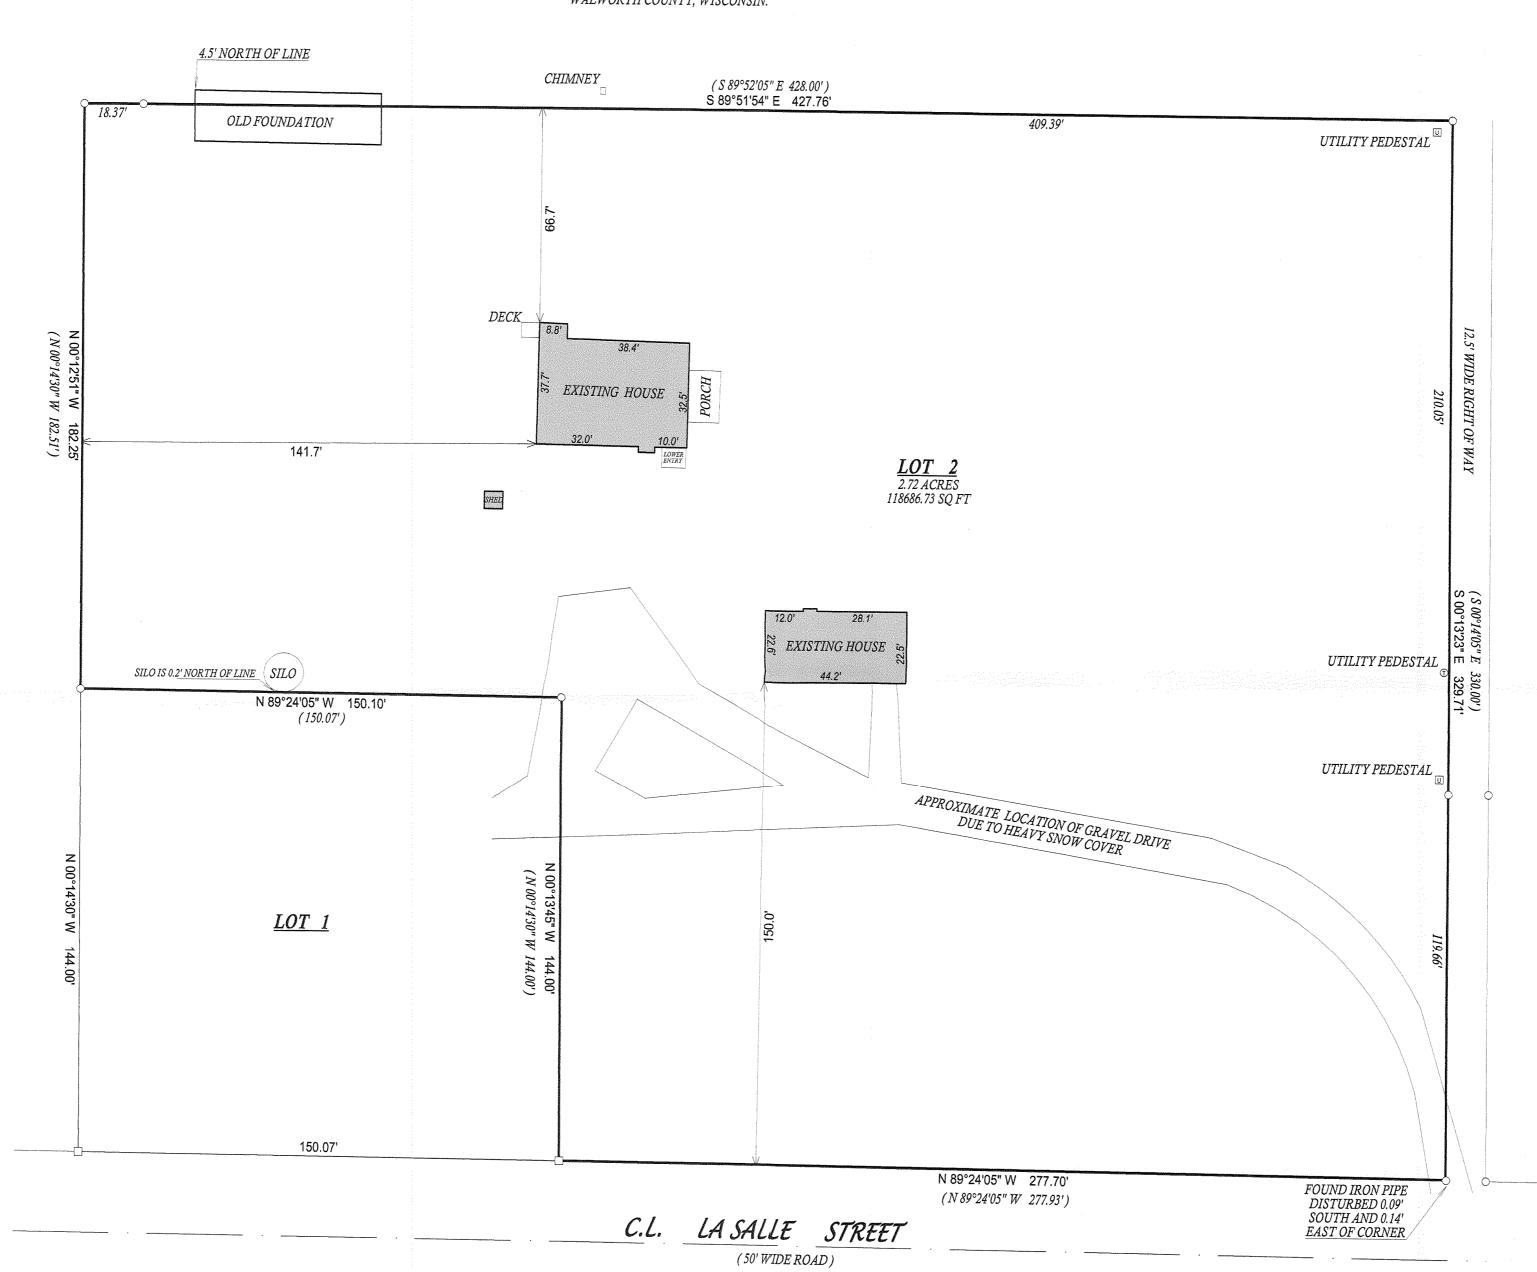

( )= recorded as

 $\Box$  = found iron bar = found iron pipe

= set iron pipe

= set iron bar

SCALE 1'' = 30'

JOB # 07-018

TAXID # ZA104200002



## NOTE: DUE TO SNOW COVER ALL IMPROVEMENTS MAY NOT BE SHOWN

COMPARE LEGAL DESCRIPTION ABOVE AND DRAWING WITH DEED. FOR BUILDING RESTRICTIONS AND EASEMENTS NOT SHOWN, REFER TO DEED, ABSTRACT SOURCES AND LOCAL MUNICIPAL CODES. NOTIFY THE SURVEYOR IMMEDIATELY OF ANY DISCREPANCY.

"I hereby certify that I have surveyed the above described property and that the above map, to the best of my knowledge and belief, is a true representation thereof and shows the size and location of all visible structures, apparent easements and encroachmentsif any."

This survey is made for the present owners of the property, and those who purchase, mortgage, or guarentee the title thereto, within one year from

the date hereof.



JOHN KROTT S - 2258 Wisconsin Registered Land Surveyor ( original if signed in red )

<u>DATED THIS THE 8th DAY OF FEBRUARY 2007.</u>