


PREPARED FOR:
STACEY SCHULTZ
KEEFE REAL ESTATE
751 GENEVA PKWY
LAKE GENEVA, WI 53147


PLAT OF SURVEY

-OF-


LOT 37 OF H.E. WELLS ADDITION TO THE CITY OF LAKE
GENEVA, WALWORTH COUNTY, WISCONSIN

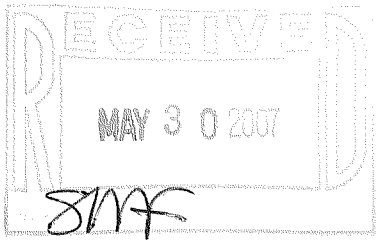

PATHFINDER SURVEYING INC.
W2888 KRUEGER ROAD, UNIT "D"
LAKE GENEVA, WI, 53147
262-248-3697

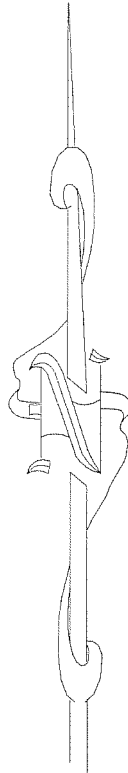

BONNIE BRAE LANE
(50' WIDE)

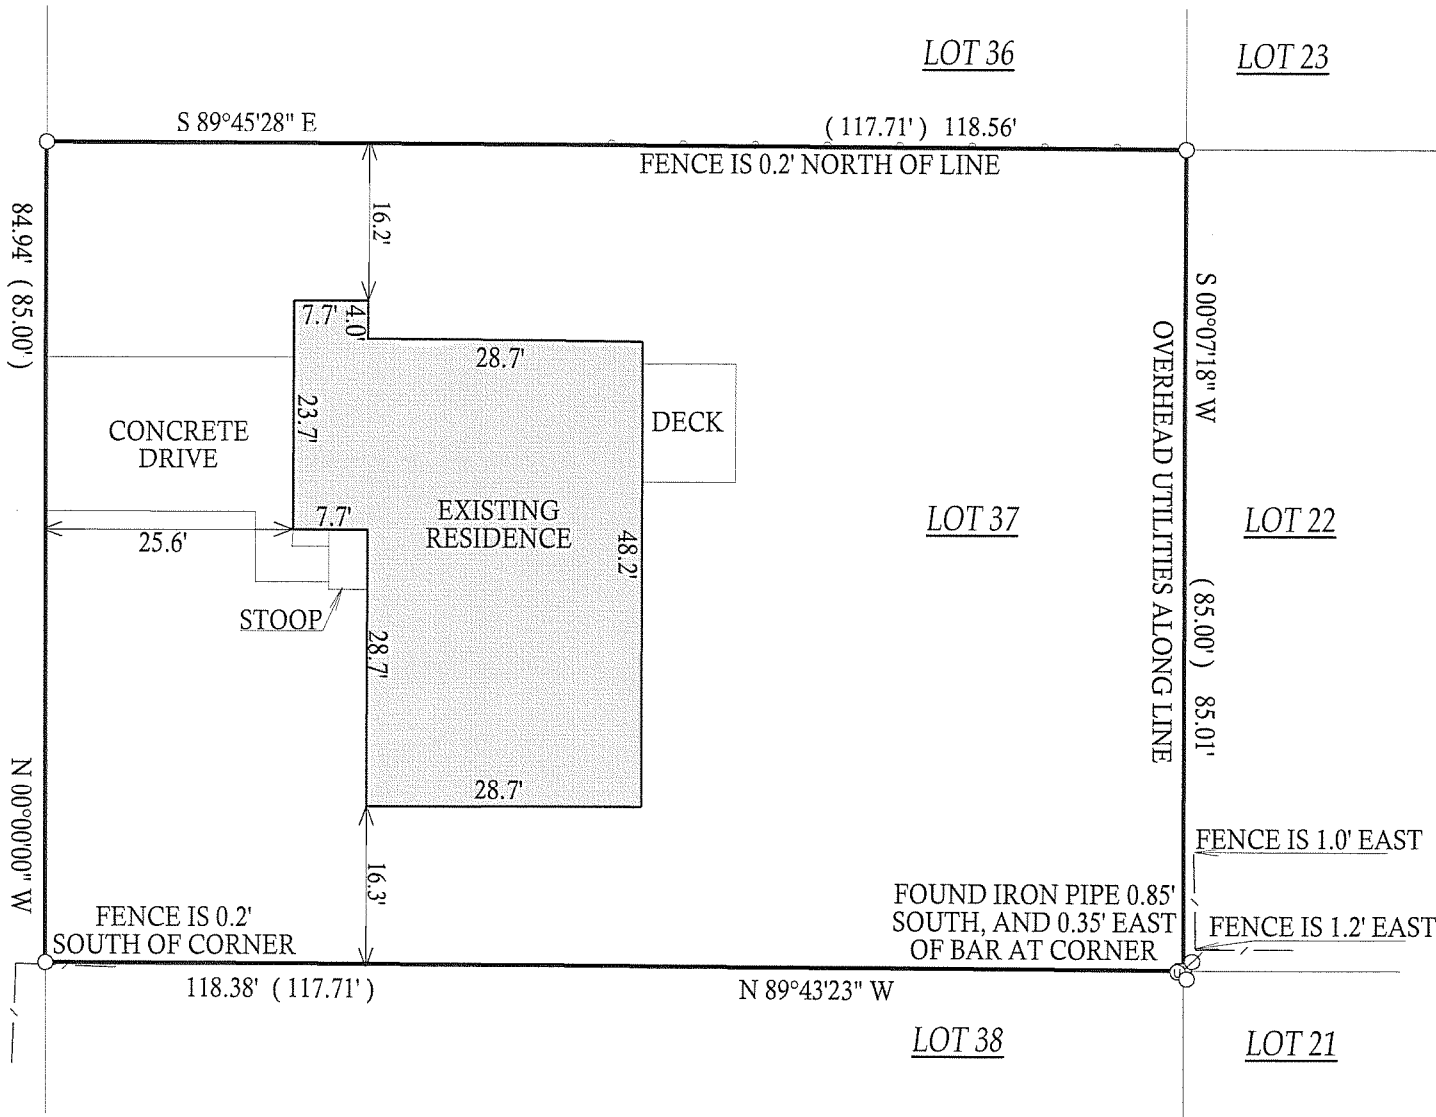

- () = RECORDED AS
- Ø = UTILITY POLE
- Ⓢ = UTILITY PEDESTAL
- = FOUND IRON BAR
- = FOUND IRON PIPE
- = SET IRON PIPE
- = SET IRON BAR


SCALE: 1" = 20'

JOB #: 07-199

TAX ID #: ZWE 00037

COMPARE LEGAL DESCRIPTION ABOVE AND DRAWING WITH DEED, FOR BUILDING RESTRICTIONS AND EASEMENTS NOT SHOWN. REFER TO DEED, ABSTRACT SOURCES AND LOCAL MUNICIPAL CODES. NOTIFY THE SURVEYOR IMMEDIATELY OF ANY DISCREPANCY.

"I hereby certify that the above described property was surveyed under my supervision and that the above map, to the best of my knowledge and belief, is a true representation thereof and shows the size and location of all visible structures, apparent easements and encroachments if any."
This survey is made for the present owners of the property, and those who purchase, mortgage, or guarantee the title thereto, within one year from the date hereof.

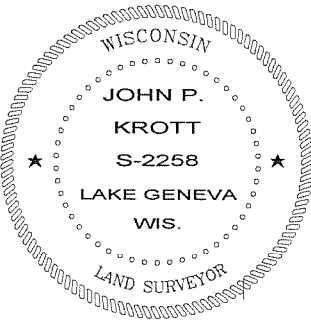

John P. Krott
JOHN KROTT S - 2258
Wisconsin Registered Land Surveyor
(original if signed in red)
DATED THE 22nd DAY OF MAY, 2007.

007-2523