

# FARRIS, HANSEN & ASSOCIATES, INC.

ENGINEERING — ARCHITECTURE — SURVEYING

7 RIDGWAY COURT — P.O. BOX 437 — ELKHORN, WISCONSIN 53121

PHONE: (262) 723-2098 FAX: (262) 723-5886

## PLAT OF SURVEY

LOTS 9 AND 12, BLOCK 1 OF ORIGINAL PLAT OF  
THE CITY OF LAKE GENEVA, WALWORTH COUNTY, WISCONSIN


— WORK ORDERED BY —  
BETTIE GIESE  
1143 WILLIAMS STREET  
LAKE GENEVA, WI 53147

### LEGEND

● = FOUND IRON REBAR STAKE

○ = FOUND IRON PIPE STAKE

{XXX} = RECORDED AS


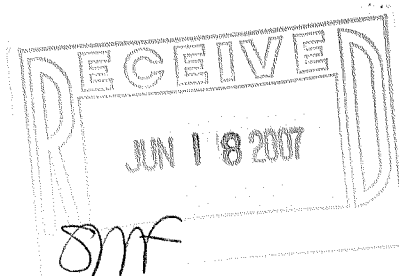


NOTE: COPIES OF THIS MAP TO WHICH THE FOLLOWING CERTIFICATE  
WILL APPLY SHOW THE SURVEYOR'S ORIGINAL SEAL AND SIGNATURE  
IN RED INK. COPIES BY ANY OTHER MEANS MAY HAVE ALTERATIONS  
WHICH DO NOT REPRESENT THE SURVEYOR'S WORK PRODUCT.

I HEREBY CERTIFY THAT THE ABOVE DESCRIBED PROPERTY HAS BEEN  
SURVEYED UNDER MY DIRECTION AND THAT THE ABOVE MAP IS A TRUE  
REPRESENTATION THEREOF AND SHOWS THE SIZE AND LOCATION OF  
THE PROPERTY AND ITS EXTERIOR BOUNDARIES. THIS SURVEY IS  
MADE FOR THE USE OF THE PRESENT OWNERS OF THE PROPERTY, AND  
ALSO THOSE WHO PURCHASE, MORTGAGE, OR GUARANTEE THE TITLE  
THERE TO WITHIN ONE YEAR FROM THE DATE HEREOF.

DATED: MAY 18, 2007

PETER S. GORDON R.L.S. 2101

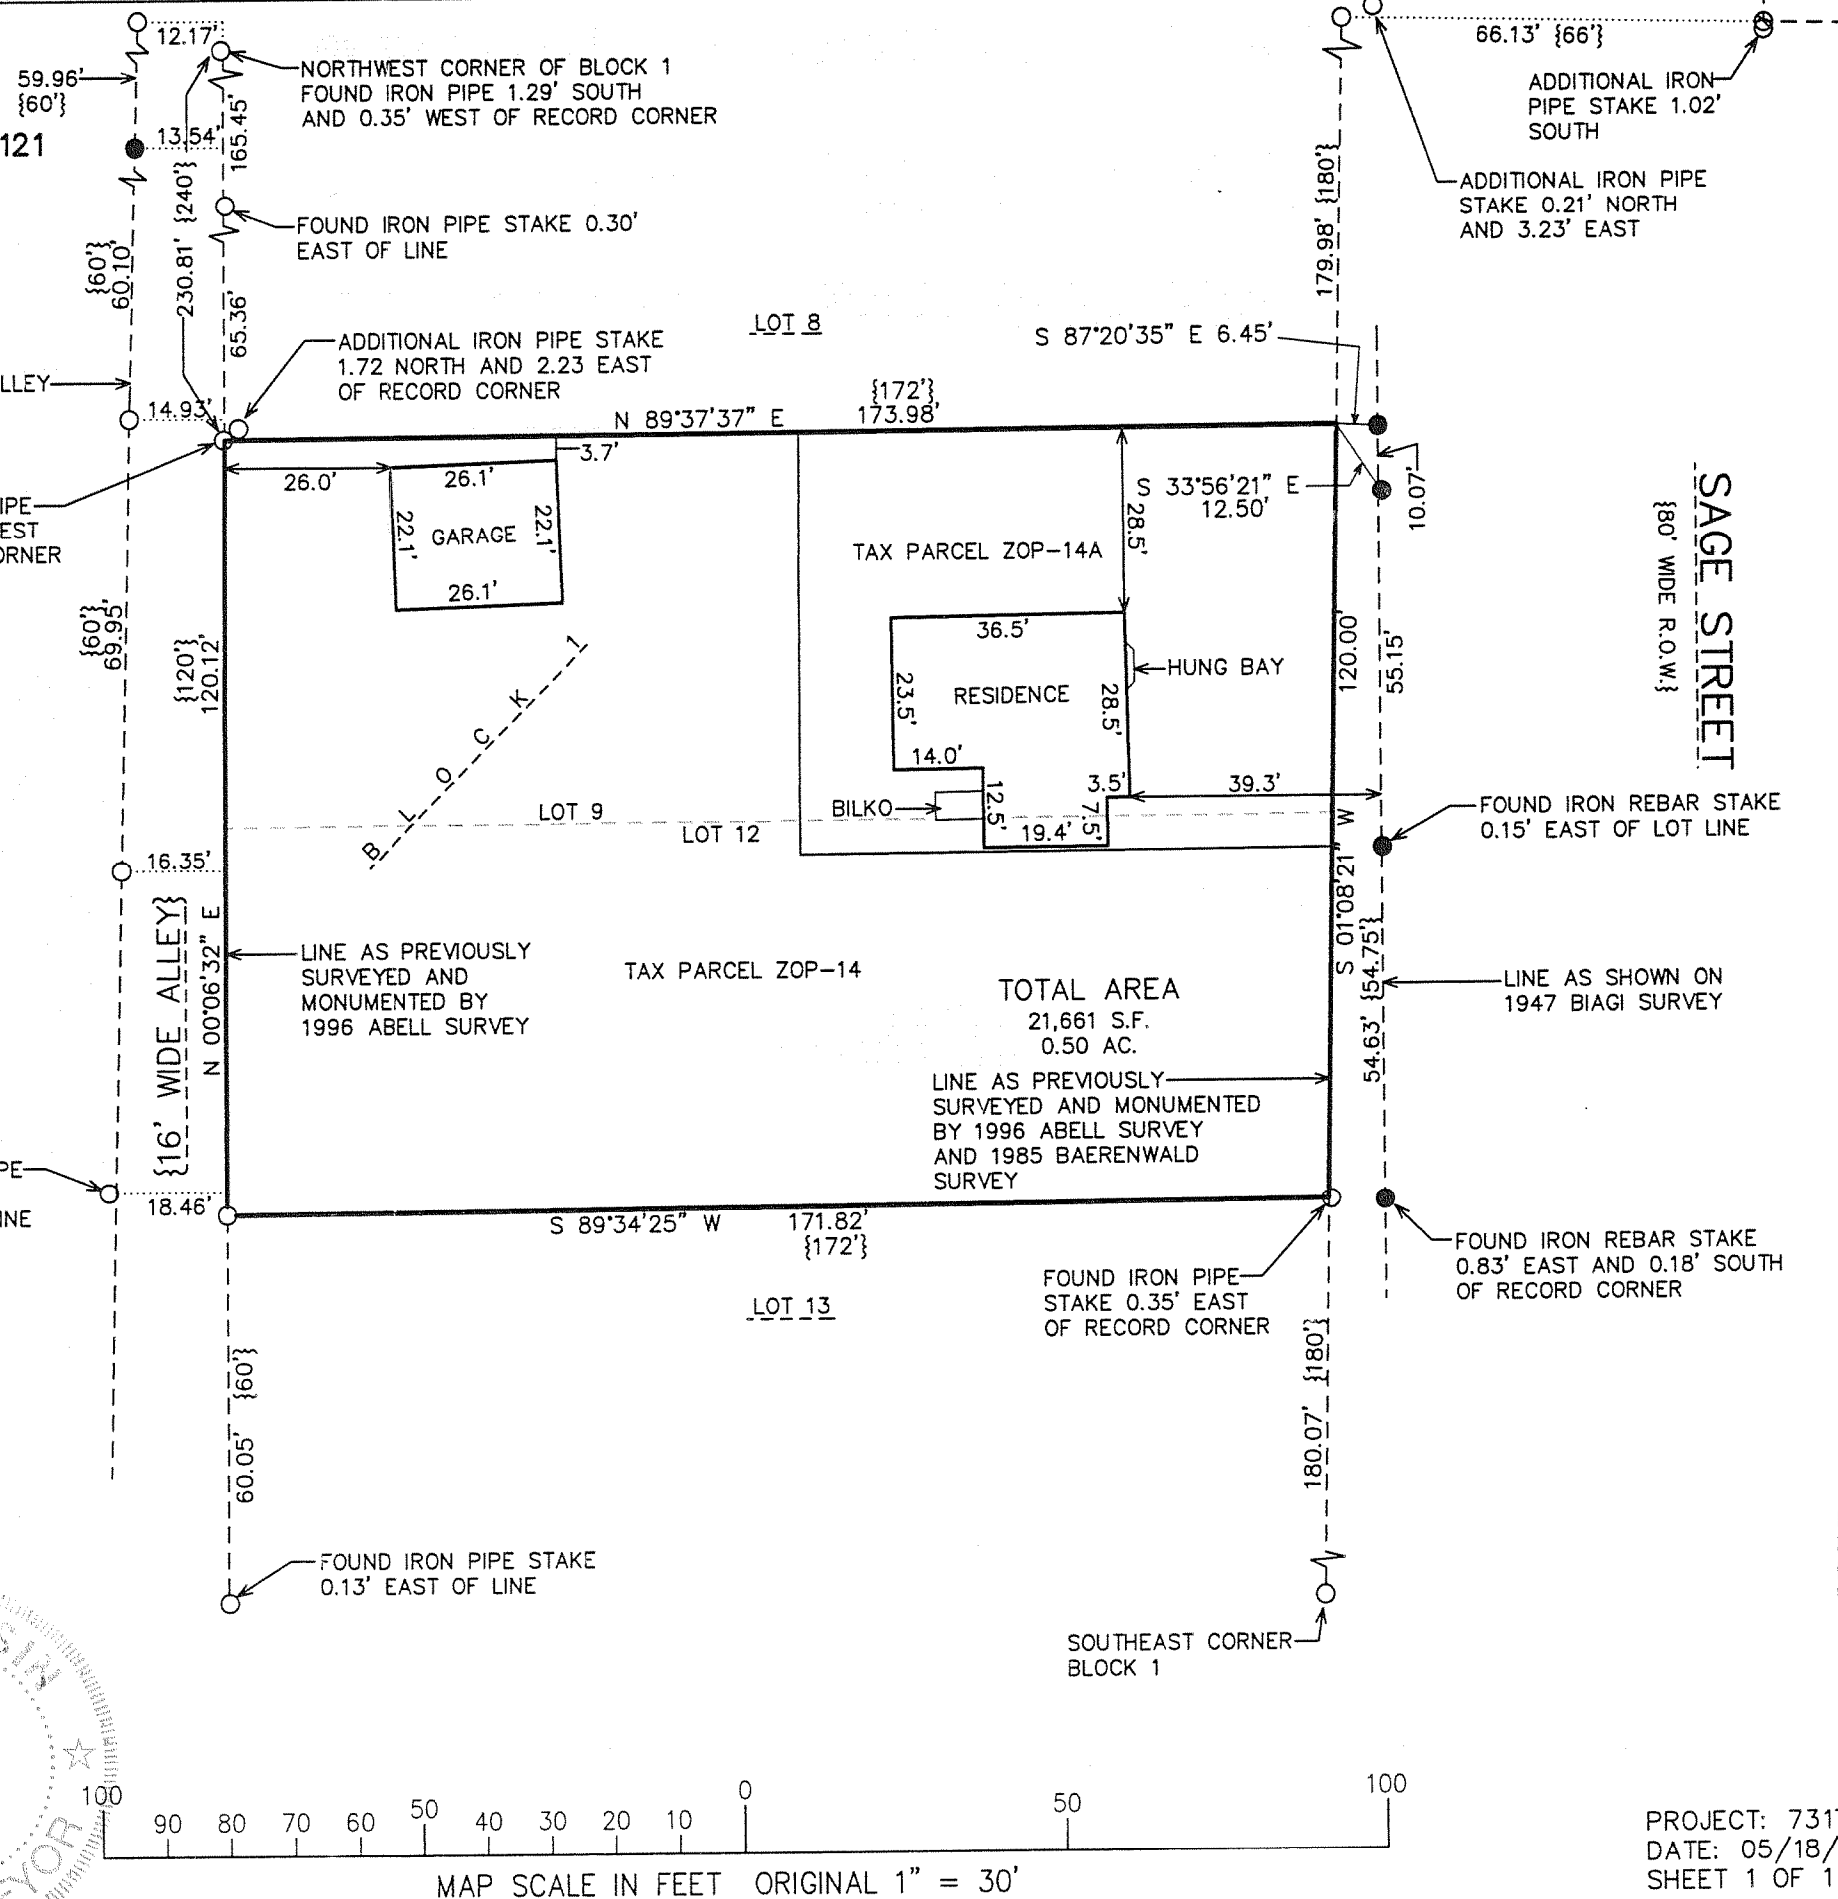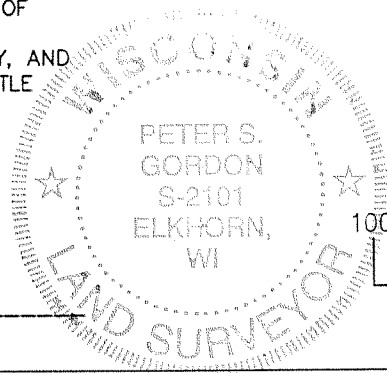

PROJECT: 7317  
DATE: 05/18/2007  
SHEET 1 OF 1

X:\Projects\7317\Drawn\Survey\20070531

007-2533

ZOP-14A + ZOP-14