
ABELL SURVEYING & MAPPING

1140 SEQUOIA STREET . DELAVAN, WISCONSIN 53115 262-728-6737

H H

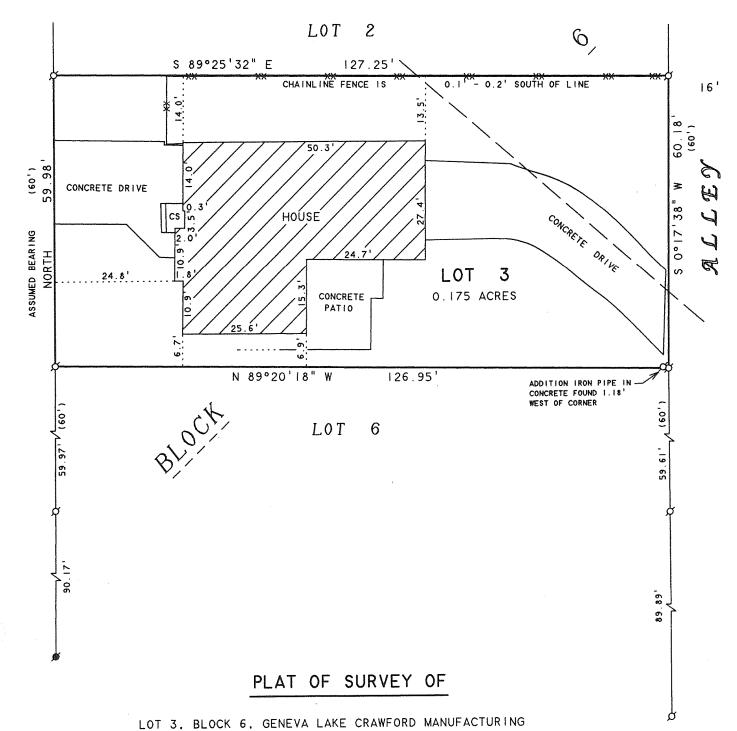

COMPANY'S ADDITION. CITY OF LAKE GENEVA, WALWORTH

COUNTY, WISCONSIN.

SCALE | " = 20"

LEGEND

Ø - IRON PIPE FOUND # - IRON ROD FOUND - OVERHEAD UTILITY LINES CS - CONCRETE STOOP - CHAINLINK FENCE

()- RECORDED AS



I HEREBY CERTIFY THAT I HAVE SURVEYED THE ABOVE DESCRIBED PROPERTY AND THAT THE ABOVE MAP IS A TRUE REPRESENTATION THEREOF AND SHOWS THE SIZE AND LOCATION OF THE PROPERTY. ITS EXTERIOR BOUNDARIES. THE LOCATION OF ALL VISIBLE STRUCTURES AND DIMENSIONS OF ALL PRINCIPAL BUILDINGS THEREON. BOUNDARY FENCES. APPARENT EASEMENTS. ROADWAYS AND VISIBLE ENCROACHMENTS, IF ANY, TO THE BEST OF MY KNOWLEDGE AND BELIEF.

THIS SURVEY IS MADE FOR THE USE OF THE PRESENT OWNERS OF THE PROPERTY. AND ALSO THOSE WHO PURCHASE, MORTGAGE, OR GUARANTEE THE TITLE THERETO WITHIN ONE (I) YEAR FROM DATE HEREON.

ORDERED BY: KEVIN O'CONNOR 1223 CENTER STREET LAKE GENEVA. WI 53147 DAVID F. ABELL WISCONSIN REGISTERED LAND SURVEYOR, S-1596

DATE JOB NUMBER - 07022 NOTE: THIS IS NOT A CERTIFIED COPY UNLESS SEALED.

ZOC-12A