



PREPARED FOR
PIER DOCTORS
W6489 N. WALWORTH RD.
WALWORTH, WI. 53184

RIPARIAN RIGHTS SURVEY


PATHFINDER SURVEYING INC.
UNIT D W2888 KRUGER RD.
LAKE GENEVA WI. 53147

- OF -

LOT 7 OF GREENRIDGE DOWNS, A SUBDIVISION LOCATED IN THE
CITY OF LAKE GENEVA, WALWORTH COUNTY, WISCONSIN.

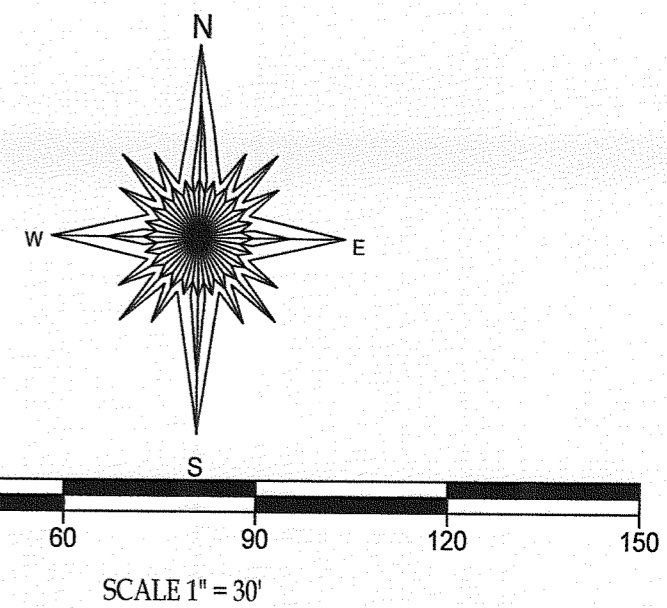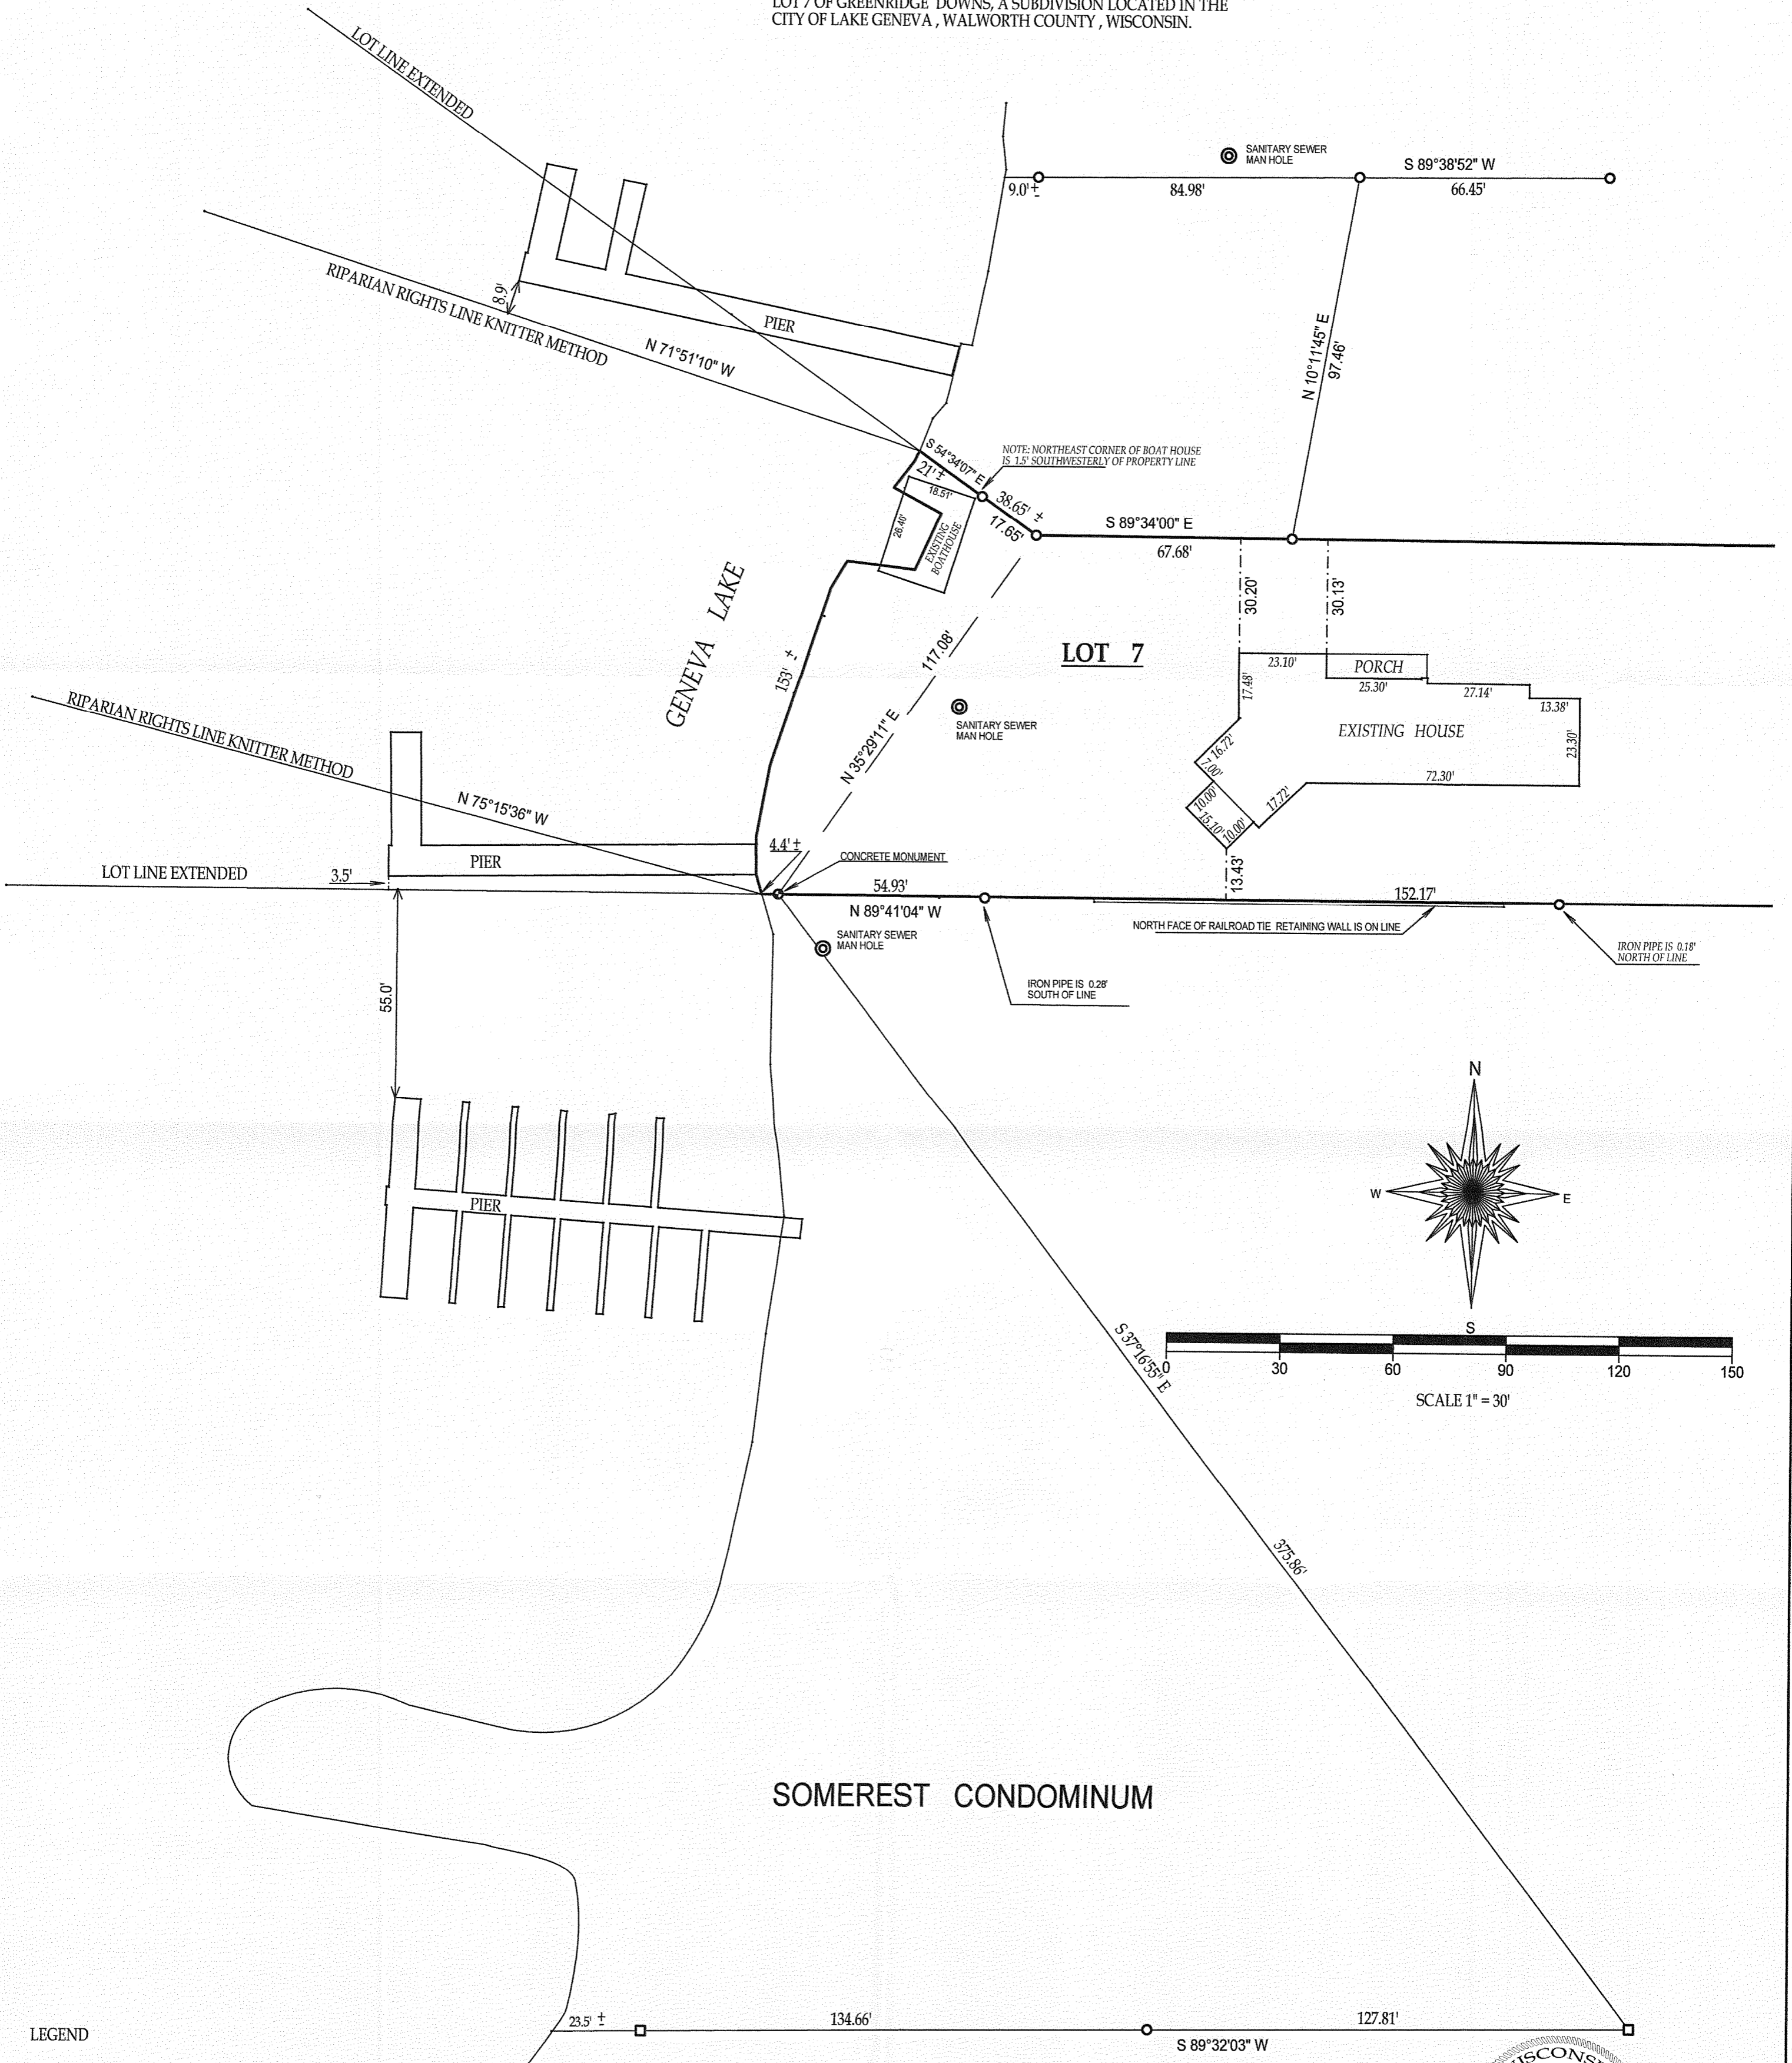

LEGEND
() = recorded as
○ = iron pipe found
● = iron pipe set
SCALE 1" = 30'
JOB # 02-238RIP
TAX ID # ZGR-4

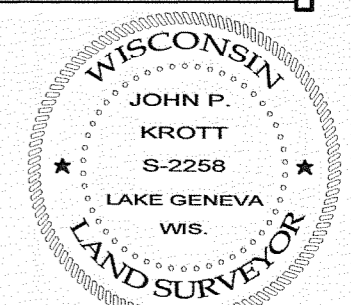

DATED THIS 30th, DAY OF JULY, 2007
John P. Krott
JOHN KROTT S - 2258
Wisconsin Registered Land Surveyor
(original if signed in red)

007-2546