PREPARED FOR: LINDA ZENGER 215 HEATHER LANE WOODALE, IL 60191


PLAT OF SURVEY

PATHFINDER SURVEYING, INC. W2888 KRUEGER ROAD UNIT "D" LAKE GENEVA, WI 53147 (262) 248-3697

 
UNIT 12 OF SOMMERSET CONDOMINIUMS, LOCATED IN THE NORTHWEST 1/4 OF SECTION 1, TOWN 1 NORTH, RANGE 17 EAST, CITY OF LAKE GENEVA, WALWORTH COUNTY, AND STATE OF WISCONSIN.

TIFFANY DRIVE

(50' WIDE)

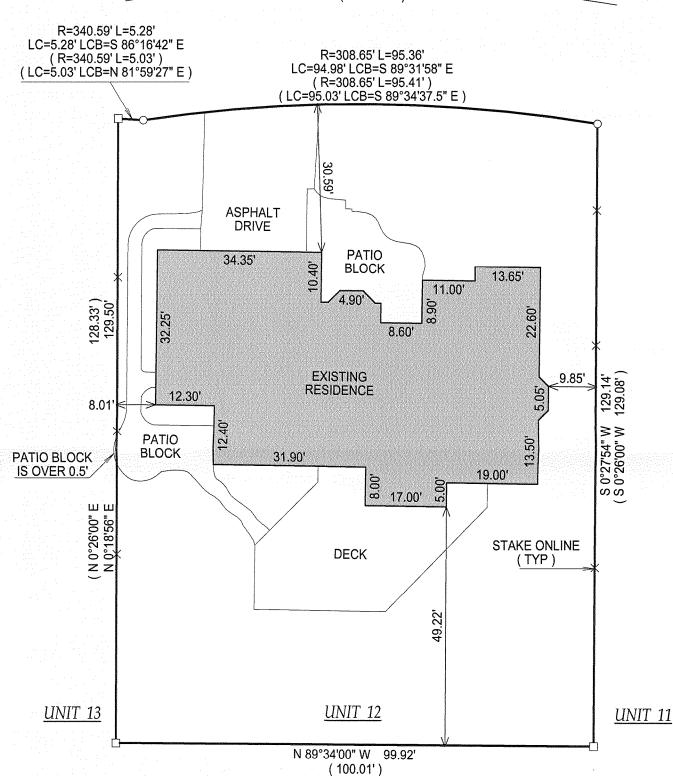





= FOUND IRON BAR

= FOUND IRON PIPE

= SET IRON BAR

= SET IRON PIPE

SCALE: 1'' = 20'

IOB #: 07-355

TAXAD #: ZCNS 00012

NOTE: BASIS OF BEARING IS RECORD PLAT.

COMPARE LEGAL DESCRIPTION ABOVE AND DRAWING WITH DEED. FOR BUILDING RESTRICTIONS AND EASEMENTS NOT SHOWN, REFER TO DEED, ABSTRACT SOURCES AND LOCAL MUNICIPAL CODES. NOTIFY THE SURVEYOR IMMEDIATELY OF ANY DISCREPANCY.

"I hereby certify that the above described property was surveyed under my supervision and that the above map, to the best of my knowledge and belief, is a true representation thereof and shows the size and location of all visible structures, apparent easements and encroachments if any." This survey is made for the present owners of the property, and those who purchase, mortgage, or guarentee the title thereto, within one year from the date hereof.



JEFFREY L KIMPS 48-2436 Wisconsin Registered Land Surveyor (original if signed in red)

DATED THIS 9th DAY OF AUGUST, 2007.