




CAMPBELL STREET

PATHFINDER SURVEYING INC.
W2888 KRUEGER RD. UNIT "D"
LAKE GENEVA WI. 53147
(262) 248-3697

ALL THAT PART OF BLOCK 41 IN THE ORIGINAL PLAT OF THE VILLAGE (NOW CITY) OF LAKE GENEVA, BEING A SUBDIVISION OF PARTS OF SECTION 36, IN TOWNSHIP 2 NORTH, RANGE 17 EAST, IN THE CITY OF LAKE GENEVA, BOUNDED AND DESCRIBED AS FOLLOWS, TO-WIT :

PARCEL 2: THE EAST 12 FEET OF THE FOLLOWING DESCRIBED PREMISES :
BEGINNING AT AN IRON STAKE IN THE EAST LINE OF WILLOW STREET IN THE CITY
OF LAKE GENEVA, THAT IS 1485.56 FEET NORTH OF THE SOUTH LINE OF SECTION
36, IN TOWNSHIP 2 NORTH, RANGE 17 EAST, OF THE FOURTH PRINCIPAL MERIDIAN;
THENCE EAST IN THE NORTH LINE OF LANDS FORMERLY SOLD BY CHARLES H. BAKER
TO WILLIAM HINK, 160.5 FEET TO AN IRON STAKE; THENCE NORTH 72.5 FEET TO AN
IRON STAKE IN THE SOUTH LINE OF CAMPBELL STREET IN SAID CITY, THENCE WEST
IN THE SOUTH LINE OF SAID CAMPBELL STREET 158.5 FEET TO AN IRON STAKE IN THE
SOUTHEAST CORNER OF SAID WILLOW AND CAMPBELL STREETS; THENCE SOUTH IN
THE EAST LINE OF SAID WILLOW STREET 72.5 FEET TO THE PLACE OF BEGINNING.


PARCEL 3 : BEGIN AT AN IRON STAKE IN THE SOUTH LINE OF CAMPBELL STREET AT THE POINT OF INTERSECTION OF SAID SOUTH LINE WITH THE EAST LINE OF WILLOW STREET IN THE CITY OF LAKE GENEVA; RUN THENCE EAST IN THE SOUTH LINE OF CAMPBELL STREET 146.5 FEET TO A POINT WHICH IS 12 FEET WEST OF A LIKE IRON STAKE SET IN THE SOUTH LINE OF CAMPBELL STREET; RUN THENCE SOUTH 72.75 FEET PARALLEL TO THE EAST LINE OF WILLOW STREET WHICH IS 148.3 FEET EAST OF AN IRON STAKE SET AT THE SOUTH WEST CORNER OF THE PARCEL OF REAL ESTATE OWNED BY MERRILL JOHNSON AND RUTH JOHNSON AND WHICH POINT MARKS THE POINT OF BEGINNING IN THE DESCRIPTION OF THE PARCEL OF LAND HEREIN TO BE DESCRIBED; FROM SAID POINT OF BEGINNING RUN SOUTH 70.25 FEET TO A POINT IN THE SOUTH LINE OF LAND OF THE GRANTOR WHICH POINT IS 150 FEET EAST OF A STAKE SET AT THE SOUTHWEST CORNER OF THE PARCEL OF LAND OWNED BY SAID GRANTOR; RUN THENCE EAST IN SAID SOUTH LINE OF THE LAND OF THE GRANTOR 12 FEET TO THE SOUTHWEST CORNER OF LAND HERETOFORE CONVEYED TO THE GRANTEES ; THENCE NORTH IN THE WEST LINE OF THE LAND OF THE SAID GRANTEES 70.25 FEET; THENCE WEST 12 FEET TO THE POINT OF BEGINNING. INTENDING HEREBY TO CONVEY A STRIP OF LAND OF THE UNIFORM WIDTH OF 12 FEET OFF FROM THE ENTIRE EAST END OF THE PARCEL OF LAND OWNED BY THE GRANTOR.

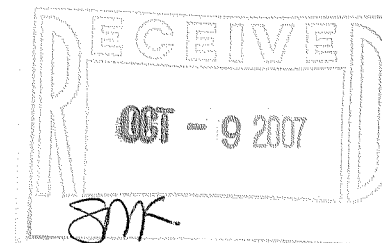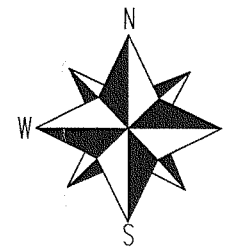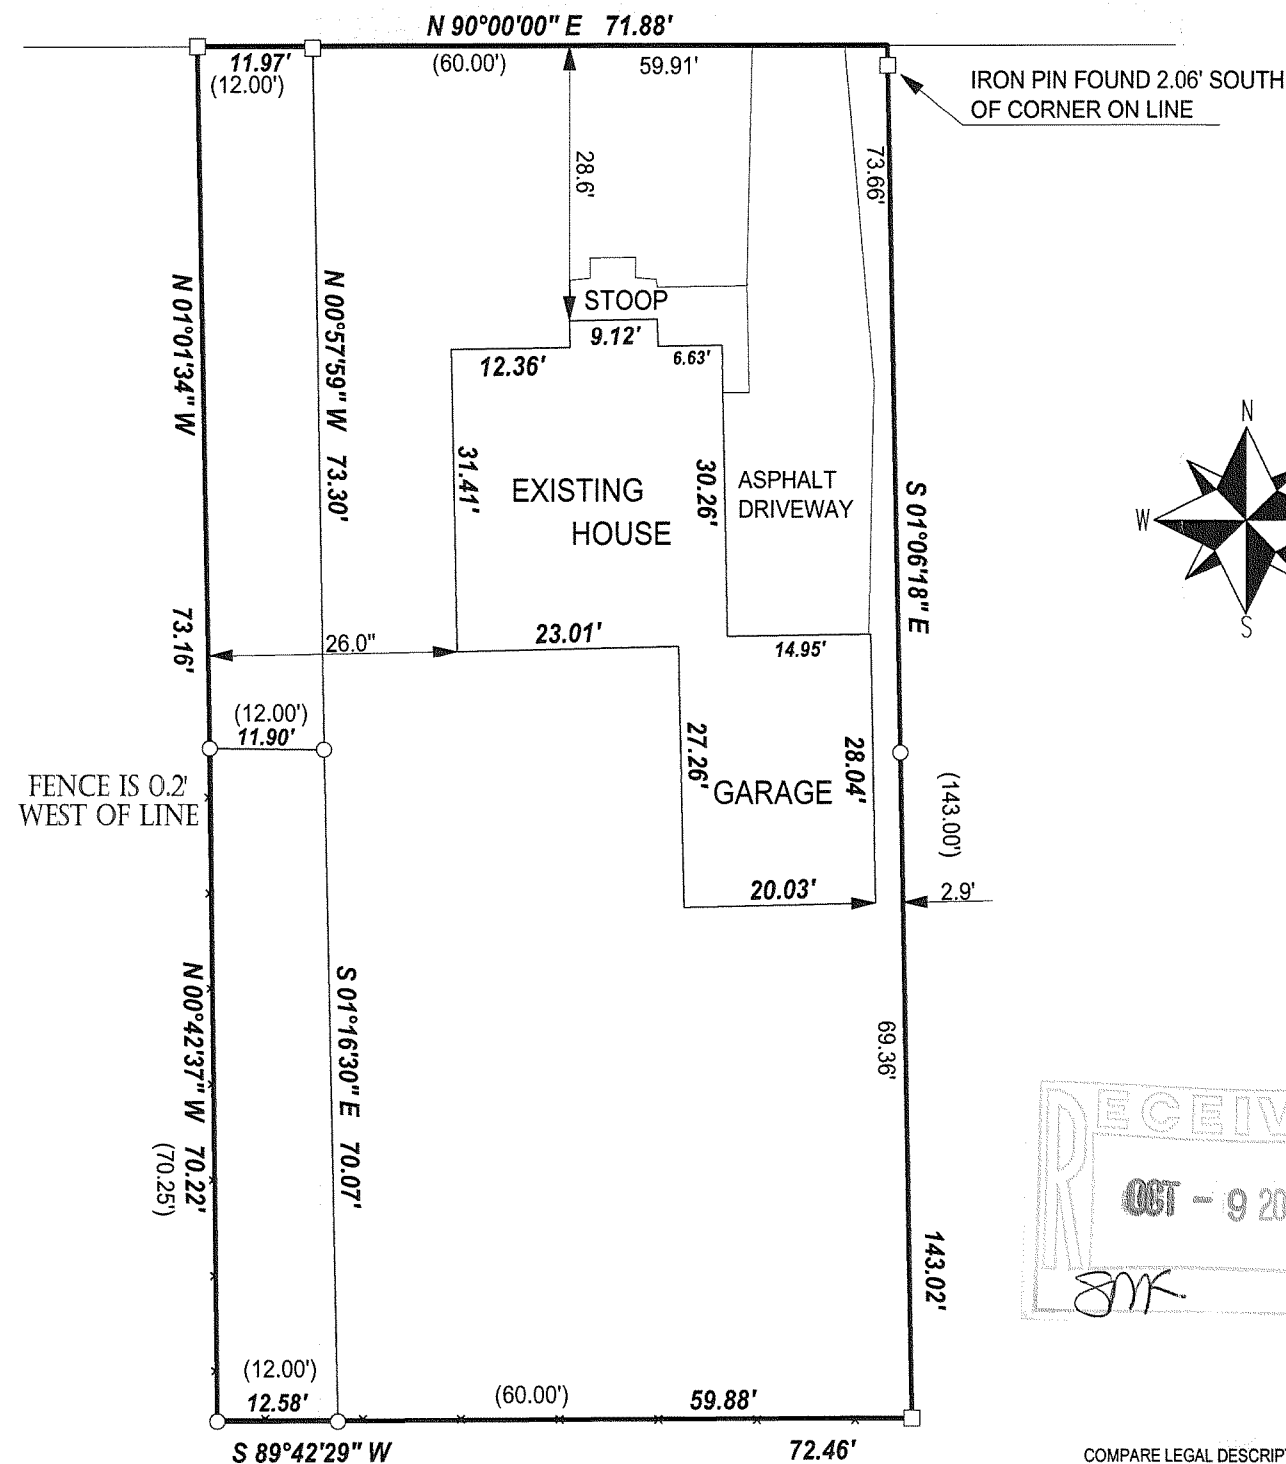

COMPARE LEGAL DESCRIPTION ABOVE AND DRAWING WITH DEED. FOR BUILDING RESTRICTIONS AND EASEMENTS NOT SHOWN, REFER TO DEED, ABSTRACT SOURCES AND LOCAL MUNICIPAL CODES. NOTIFY THE SURVEYOR IMMEDIATELY OF ANY DISCREPANCY.

"I hereby certify that I have surveyed the above described property and that the above map, to the best of my knowledge and belief, is a true representation thereof and shows the size and location of all visible structures, apparent easements and encroachments if any."

This survey is made for the present owners of the property, and those who purchase, mortgage, or guarantee the title thereto, within one year from the date hereof.

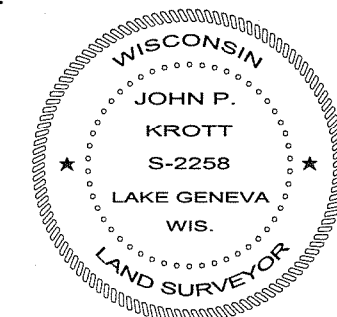

John P. Kroll

JOHN KROTT S - 2258
Wisconsin Registered Land Surveyor
(original if signed in red)

DATED THIS THE 11th DAY OF JULY 2007.

007-2554

TAX ID # ZOP00401