

PREPARED FOR:
SCOTT JOHNSON
REMAX GENEVA REALTY
101 BROAD ST. SUITE 102
LAKE GENEVA, WI 53147




PLAT OF SURVEY

- OF -

PATHFINDER SURVEYING INC.
W2888 KRUEGER ROAD, UNIT "D"
LAKE GENEVA, WI, 53147
262-248-3697

THE WEST 1/2 OF LOT 12 OF FERGUSON'S ADDITION,
LOCATED IN THE CITY OF LAKE GENEVA,
WALWORTH COUNTY, WISCONSIN

HENRY STREET
(66' WIDE)

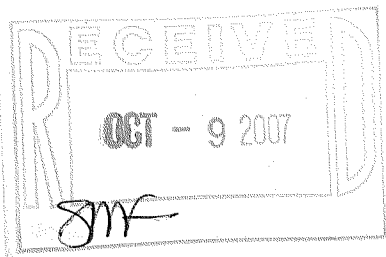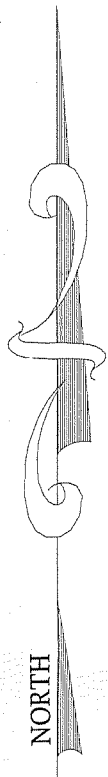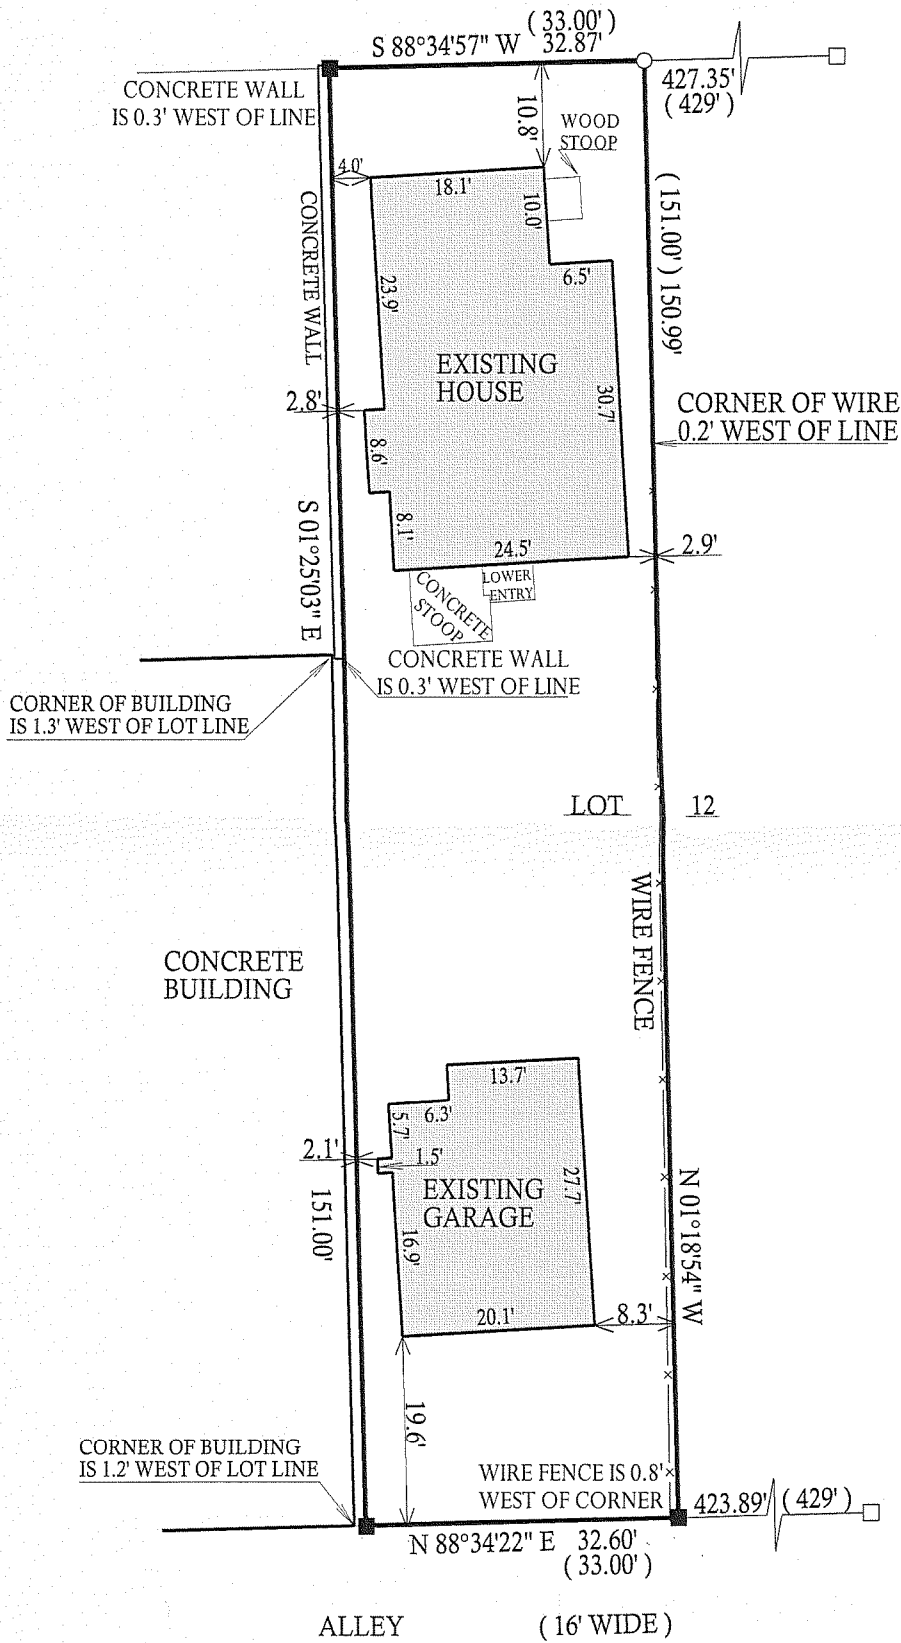

- () = recorded as
- = found iron bar
- = found iron pipe
- * = set iron pipe
- = set iron bar

NOTE: BEARINGS ARE ASSUMED

COMPARE LEGAL DESCRIPTION ABOVE AND DRAWING WITH DEED. FOR BUILDING RESTRICTIONS AND EASEMENTS NOT SHOWN, REFER TO DEED, ABSTRACT SOURCES AND LOCAL MUNICIPAL CODES. NOTIFY THE SURVEYOR IMMEDIATELY OF ANY DISCREPANCY.


SCALE 1" = 20'

JOB # 07-229

TAX ID # ZF00012

"I hereby certify that I have surveyed the above described property and that the above map is a true representation thereof and shows the size and location of all visible structures, apparent easements and encroachments if any."
This survey is made for the present owners of the property, and those who purchase, mortgage, or guarantee the title thereto, within one year from the date hereof.

DATED THIS 28th, DAY OF MAY 2007.

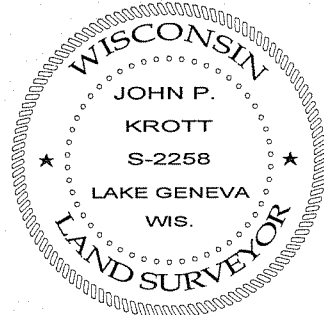

John P. Krott
JOHN KROTT S - 2258
Wisconsin Registered Land Surveyor
(original if signed in red)

007-2558