PREPARED FOR FRED GELDERMANN REMAX GENEVA REALTY 101 BROAD ST. SUITE 102 LAKE GENEVA WI. 53147

PLAT OF SURVEY

-OF-


KROTT SUR VEYING INC.

N3705 WILLOW BEND LANE
LAKE GENEVA WI. 53147
PHONE # (262)248-3697
FAX # (262)249-0639

LOT 3, BLOCK 3 OF WHEELER'S ADDITION TO THE CITY OF LAKE GENEVA, LOCATED IN THE SOUTHWEST 1/4 OF SECTION 25, TOWN 2 NORTH, RANGE 17 EAST, CITY OF LAKE GENEVA, WALWORTH COUNTY, WISCONSIN.

C.L. GRANT STREET

(60' WIDE)

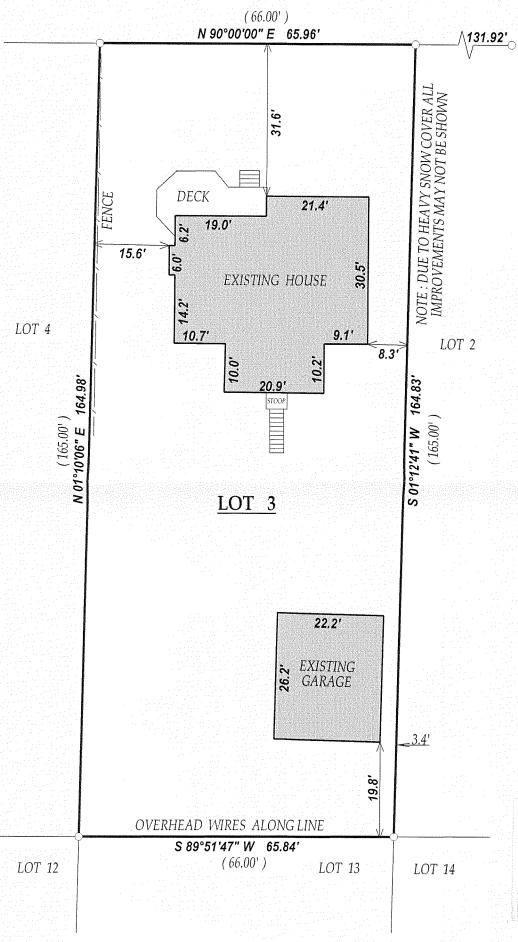

APR 18 2008

SCALE 1" = 20' S

20 40 6

COMPARE LEGAL DESCRIPTION ABOVE AND DRAWING WITH DEED.
FOR BUILDING RESTRICTIONS AND EASEMENTS NOT SHOWN, REFER
TO DEED, ABSTRACT SOURCES AND LOCAL MUNICIPAL CODES. NOTIFY
THE SURVEYOR IMMEDIATELY OF ANY DISCREPANCY.

"I hereby certify that I have surveyed the above described property and that the above map is a true representation thereof and shows the size and location of all visible structures, apparent easements and encroachments if any."

This survey is made for the present owners of the property, and those who purchase, mortgage, or guarentee the title thereto, within one year from the date hereof.

NOTE: GRANT STREET WAS ASSUMED TO BEAR EAST - WEST.

JOHN P. S-2258 **

LAKE GENEVA **

VIS. SURVE HER

JOHN KROTT S - 2258 Wisconsin Registered Land Surveyor (original if signed in red)

JOB # 08-018 TAX ID # ZWH00011A

DATED THIS THE 19th DAY OF FEBRUARY 2008.

ZWH-11A

LEGEND

O FOUND IRON PIPE

(XX) RECORDED AS