


(N)
IRON STAKES
162.42'

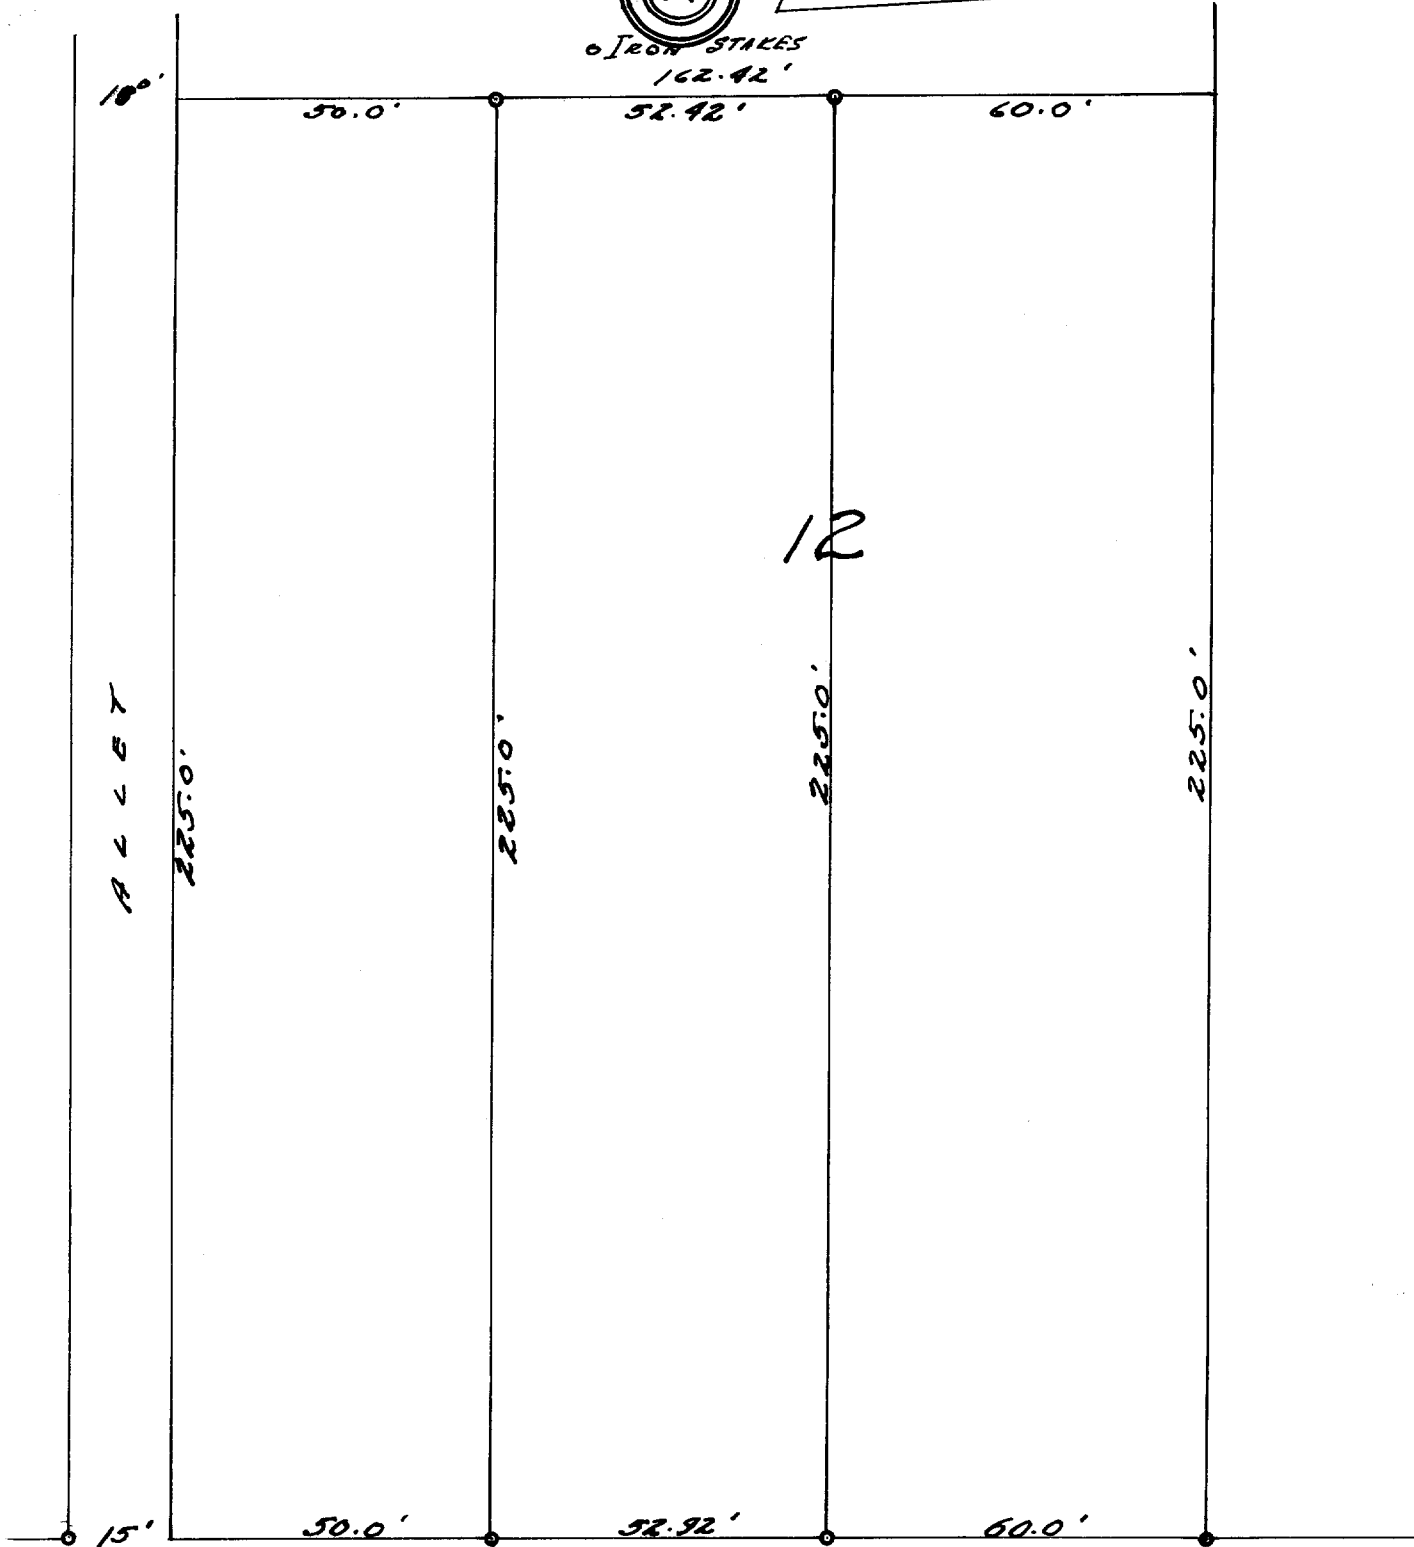

DESCRIPTION:

All of the E. $\frac{1}{2}$ of Lot 12, Columbian Second Subdivision of a portion of the Village (now city) of Lake Geneva, Walworth County, Wisconsin, excepting the south 50 feet thereof and the north 60 feet thereof.

CERTIFICATE:

I, hereby certify that I, have surveyed the above described property on this the 28th day of July, 1953 and find that no encroachments exist.

SIGNED AND SEALED ON THIS THE 4TH DAY OF AUGUST 1953.

Joseph M. Biagi
Joseph M. Biagi. Professional Engr.
Elkhorn Wisconsin.

CL 2-11A

7-2513