
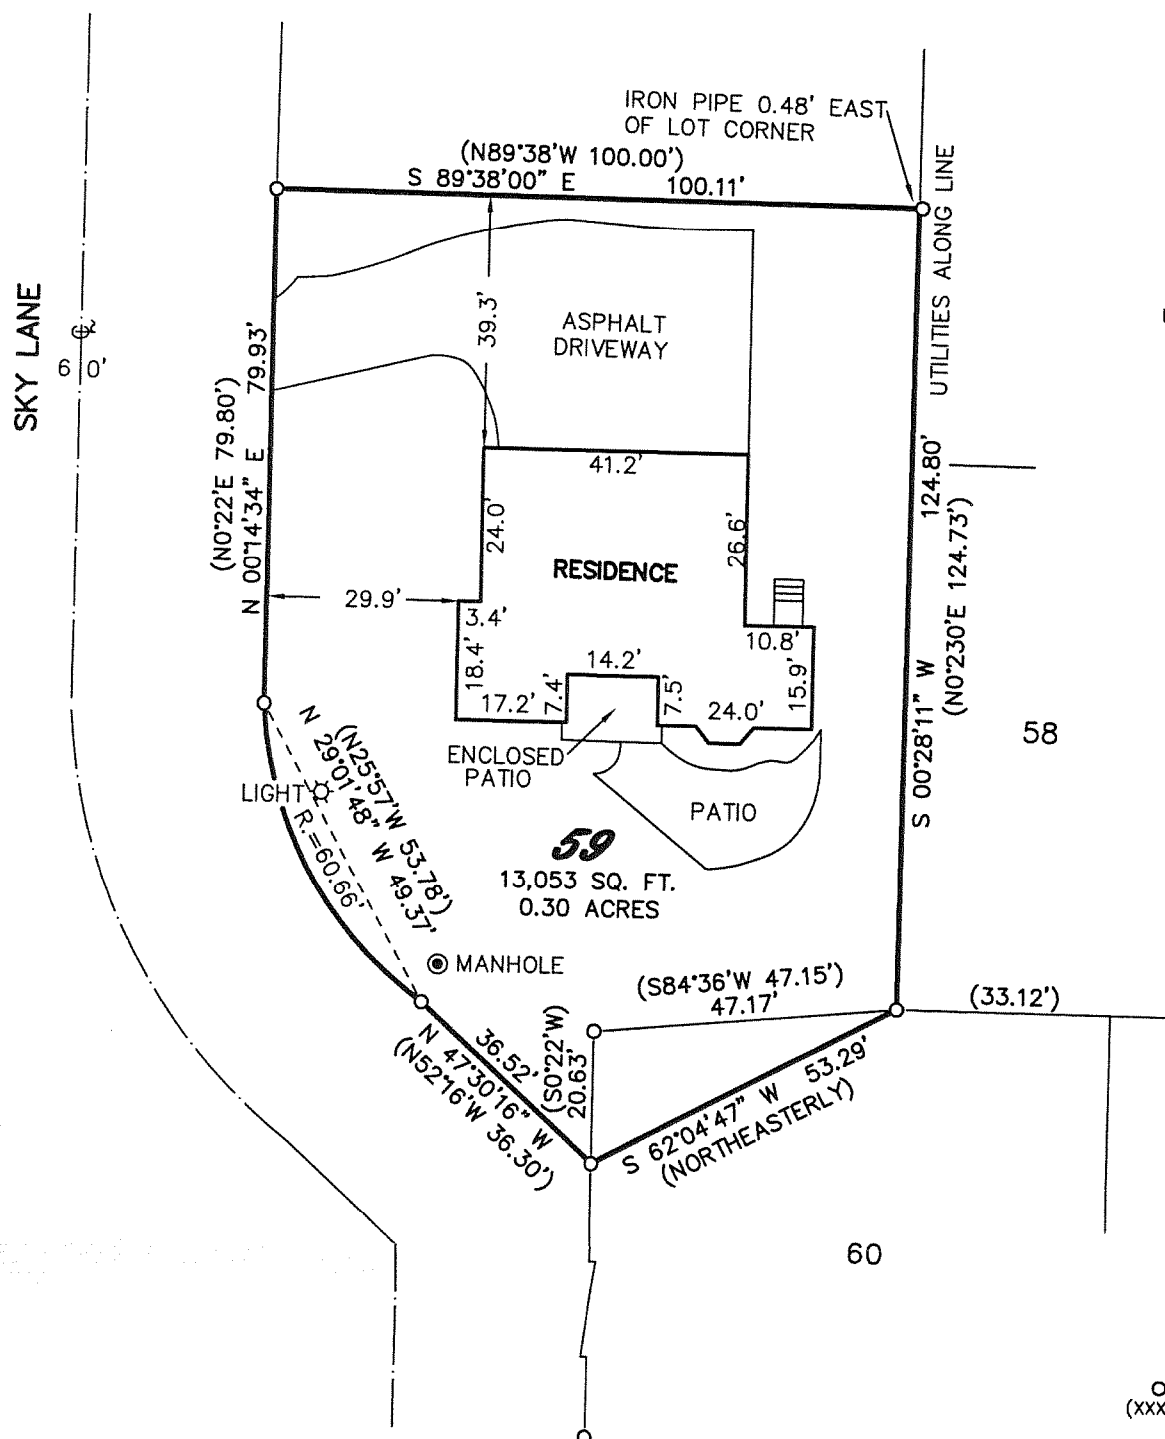
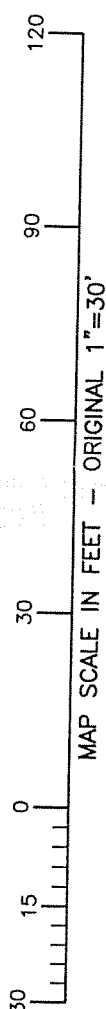


FARRIS, HANSEN & ASSOCIATES, INC.
ENGINEERING — ARCHITECTURE — SURVEYING
7 RIDGWAY COURT — P.O. BOX 437 — ELKHORN, WISCONSIN 53121
PHONE: (262) 723-2098 FAX: (262) 723-5886

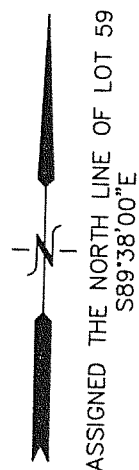

— WORK ORDERED BY —
SUSAN LEWIS
P.O. BOX 460
LAKE GENEVA, WI 53147

LEGEND
O — FOUND IRON PIPE STAKE
(XXX) — RECORDED AS



PLAT OF SURVEY

PARCEL I: Lot 59 in Sturwood Addition Number 2 in the City of Lake Geneva, according to the plat of said Addition Number 2 of record in the Office of the Register of Deeds in and for said County of Walworth, State of Wisconsin.

ALSO That part of Lot 60 of Sturwood Addition No. 2 in the City of Lake Geneva, Walworth County, Wisconsin, according to the plat of record in the office of the Register of Deeds for said county in Volume 12 of Plats, Page 73, bounded and described as follows, viz: Beginning at the Northwest corner of said lot; running thence South 0° 22' West along the West line thereof 20.63 feet; thence Northeasterly 54 feet to a point in the North line thereof which is North 89° 31' West 33.12 feet from the Northeast corner thereof; running thence South 84° 36' West 47.15 feet along the North line thereof to the place of beginning.

Tax Key No. ZST2 00015

LEGAL DESCRIPTION OF RECORD FROM TITLE COMMITMENT PROVIDED BY CLIENT

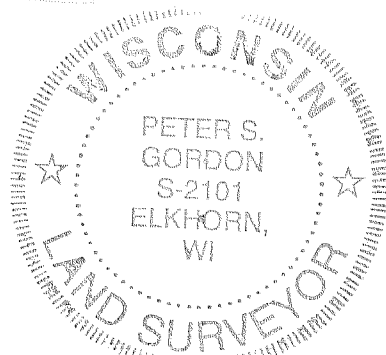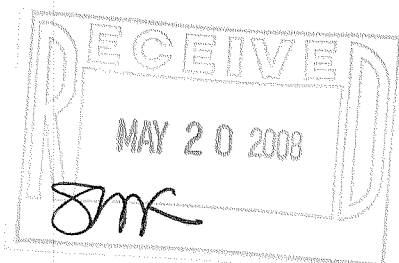

NOTE: COPIES OF THIS MAP TO WHICH THE FOLLOWING CERTIFICATE WILL APPLY SHOW THE SURVEYOR'S ORIGINAL SEAL AND SIGNATURE IN RED INK. COPIES BY ANY OTHER MEANS MAY HAVE ALTERATIONS WHICH DO NOT REPRESENT THE SURVEYOR'S WORK PRODUCT. I HEREBY CERTIFY THAT THE ABOVE DESCRIBED PROPERTY HAS BEEN SURVEYED UNDER MY DIRECTION AND THAT THE ABOVE MAP IS A TRUE REPRESENTATION THEREOF AND SHOWS THE SIZE AND LOCATION OF THE PROPERTY, ITS EXTERIOR BOUNDARIES, THE LOCATION OF ALL VISIBLE STRUCTURES, AND DIMENSIONS OF ALL PRINCIPLE BUILDINGS THEREON, BOUNDARY FENCES, APPARENT EASEMENTS, ROADWAYS, AND VISIBLE ENCROACHMENTS, IF ANY. THIS SURVEY IS MADE FOR THE USE OF THE PRESENT OWNERS OF THE PROPERTY, AND ALSO THOSE WHO PURCHASE, MORTGAGE, OR GUARANTEE THE TITLE THERETO WITHIN ONE YEAR FROM THE DATE HEREOF.

DATED: 4/15/2008

Peter S. Gordon
PETER S. GORDON

PROJECT: 7586
DATE: 04/15/2008
SHEET 1 OF 1

ZST2-15
APR 15 2008

007-2602