


ASSIGNED SOUTHWESTERLY LINE OF LOT 14
SYVER-STAD LAKE SHORE ESTATES
S 65°49'00" E

PLAT OF SURVEY

LOT 14 OF SYVER-STAD LAKE SHORE ESTATES

LOCATED IN PART OF SECTION 1, TOWN 1 NORTH,
RANGE 17 EAST, CITY OF LAKE GENEVA,
WALWORTH COUNTY, WISCONSIN
TAX KEY NO. ZSY 00014

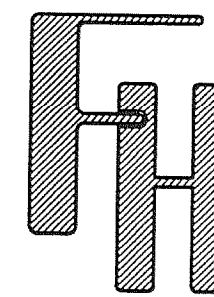

— WORK ORDERED BY —
BRIAN POLLARD
851 PARK DRIVE, SUITE 104
LAKE GENEVA, WI 53147

FARRIS, HANSEN & ASSOCIATES, INC.
ENGINEERING — ARCHITECTURE — SURVEYING
7 RIDGWAY COURT P.O. BOX 437
ELKHORN, WISCONSIN 53121
OFFICE: (262) 723-2098 FAX: (262) 723-5886

REVISIONS

PROJECT NO.
7171
DATE
10/18/06
SHEET NO.
1 OF 1

LEGEND
○ = FOUND IRON PIPE STAKE
● = FOUND IRON REBAR STAKE
(XXX) = RECORDED AS

NOTE: COPIES OF THIS MAP TO WHICH THE FOLLOWING CERTIFICATE WILL APPLY SHOW
SURVEYOR'S ORIGINAL SEAL AND SIGNATURE IN RED INK. COPIES BY ANY OTHER
MEANS MAY HAVE ALTERATIONS WHICH DO NOT REPRESENT THE SURVEYOR'S WORK
PRODUCT.

I HEREBY CERTIFY THAT THE ABOVE DESCRIBED PROPERTY HAS BEEN SURVEYED UNDER
MY DIRECTION AND THAT THE ABOVE MAP IS A TRUE REPRESENTATION THEREOF AND
SHOWS THE SIZE AND LOCATION OF THE PROPERTY, ITS EXTERIOR BOUNDARIES, THE
LOCATION OF ALL VISIBLE STRUCTURES, AND DIMENSIONS OF ALL PRINCIPLE
BUILDINGS THEREON, BOUNDARY FENCES, APPARENT EASEMENTS, ROADWAYS, AND
VISIBLE ENCROACHMENTS, IF ANY. THIS SURVEY IS MADE FOR THE USE OF THE
PRESENT OWNERS OF THE PROPERTY, AND ALSO THOSE WHO PURCHASE, MORTGAGE, OR
GUARANTEE THE TITLE THERETO WITHIN ONE YEAR FROM THE DATE HEREOF.


DATED: OCTOBER 18, 2006
PETER S. GORDON R.L.S. 2101

01/30/2007-KD
TO SHOW RIPARIAN
RIGHTS LINES

REVISED 04-25-2007
TO SHOW EASEMENT INFORMATION

REVISED 04/27/2007-KB
TO SHOW SIZE AND LOCATION
OF PROPOSED RESIDENCE

REVISED 08-18-2008
RESURVEY AND AS BUILT LOCATION

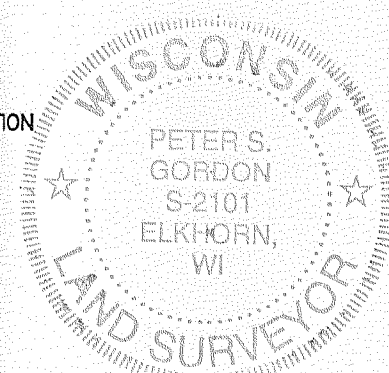

10 5 0 10 20 30 40 50 60 70
MAP SCALE IN FEET ORIGINAL 1" = 10'



BENCH MARK
CHISELED "X" ON
RIM MANHOLE
ELEV.=901.07'

ZSY-14

007-2625