
PREPARED FOR: PRIMUS HOMES, LLC

PLAT OF SURVEY

- OF -

KROTT SURVEYING, INC. N3705 WILLOW BEND LANE LAKE GENEVA, WI 53147 (262)- 248-3697

LOT 101 OF STONE RIDGE SUBDIVISION, LOCATED IN PART OF THE SOUTHEAST 1/4 OF THE SOUTHWEST AND THE SOUTHEAST 1/4 OF THE SOUTHEAST 1/4 OF SECTION 24 AND IN PART OF THE NORTHEAST 1/4 AND NORTHWEST 1/4 OF THE NORTHWEST 1/4, AND SOUTHEAST 1/4 OF THE NORTHEAST 1/4, NORTHWEST 1/4, SOUTHWEST 1/4, AND SOUTHEAST 1/4 OF THE NORTHEAST 1/4 SECTION 25, ALL IN TOWN 2 NORTH, RANGE 17 EAST, CITY OF LAKE GENEVA, WALWORTH COUNTY, WISCONSIN.

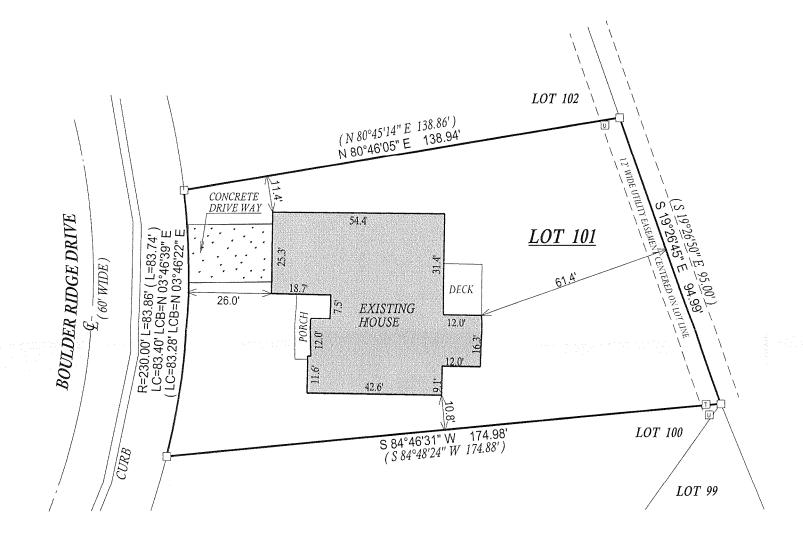

() = RECORDED AS

□ = FOUND IRON BAR

○ = FOUND IRON PIPE

= SET IRON PIPE


= SET IRON BAR

☑ =UTILITY PEDESTALS

☐ = TRANSFORMER

SCALE 1" = 30' JOB # 06-232UD_

TAX po #ZSR000101

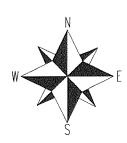





DATED THIS 24th, DAY OF SEPTEMBER, 2008

JOHN KROTT S - 2258
Wisconsin Registered Land Surveyor
(original if signed in red)

easements and encroachmentsif any."

This survey is made for the present owners of the property, and those who purchase, mortgage, or guarentee the title thereto, within one year from the date hereof.

"I hereby certify that I have surveyed the above described property and that the above map, to the best of my knowledge and belief, is a true representation thereof and shows the size and location of all visible structures, apparent