
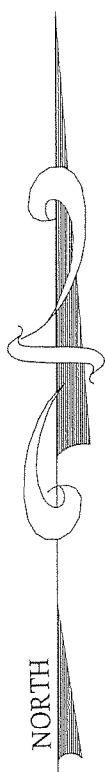


# PLAT OF SURVEY

- OF -


C.L. MAIN STREET

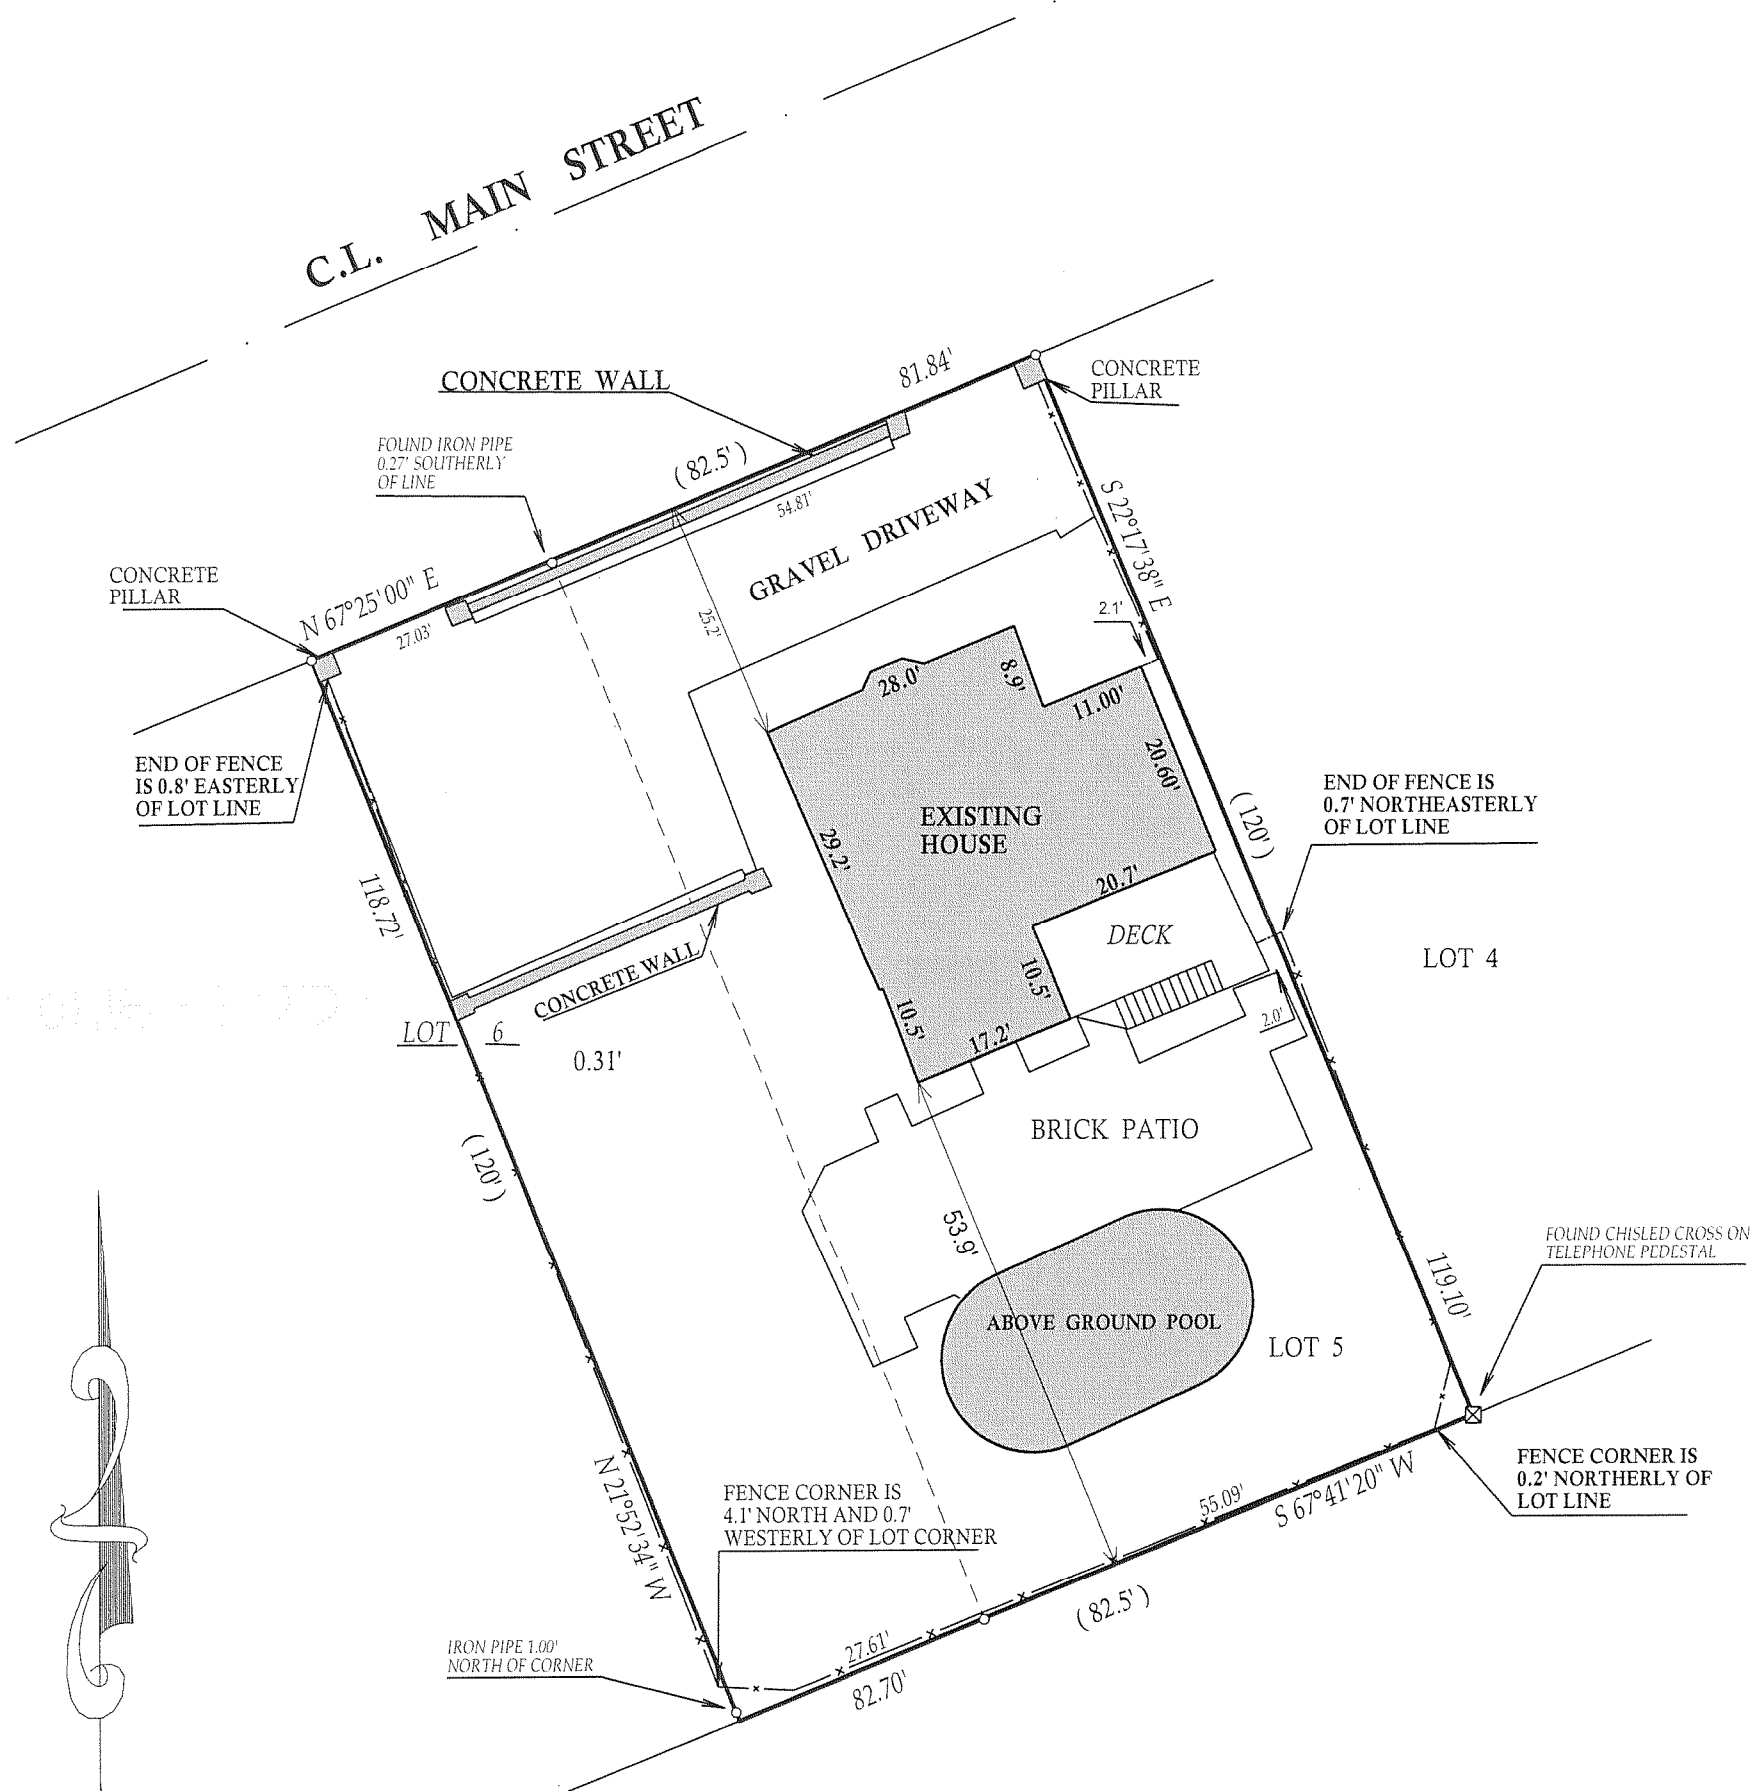

( ) = recorded as  
 □ = found iron bar  
 ○ = found iron pipe  
 ● = set iron pipe  
 ■ = set iron bar  
 SCALE 1" = 20'  
 JOB # 01-161UD  
 TAX ID # ZLM-71

RECEIVED  
AUG 24 2009  
By *JMK*



  
JOHN KROTT S - 2258  
Wisconsin Registered Land Surveyor  
( original if signed in red )

007-2667