PREPARED FOR LAVI CLAUSEN SHOREWEST REALTORS 623 MAIN ST. LAKE GENEVA WI. 53147

JOB # 03-658UD


PLAT OF SURVEY

KROTT SURVEYING INC.

N3705 WILLOW BEND LANE LAKE GENEVA WI. 53147 PHONE # (262)248-3697 FAX # (262)249-0639

- OF

LOTS 7 AND 8 IN BLOCK 14 OF LAKE GENEVA MANOR SUBDIVISION, TRACT NO. 17, EXCEPTING THE FOLLOWING DESCRIBED PREMISES: COMMENCING AT A POINT IN THE THE SOUTH BORDER LINE OF LOT 8 IN BLOCK 14 WHICH POINT IS 10 FEET IN A SOUTHWESTERLY DIRECTION FROM THE SOUTHEASTERLY CORNER OF LOT 8 IN BLOCK 14 AFORESAID; RUNNING THENCE NORTHERLY IN A STRAIGHT LINE TO THE NORTHEASTERLY CORNER OF LOT 8 BLOCK 14; THENCE IN A SOUTHERLY DIRECTION ALONG THE EASTERLY BORDER LINE OF LOT 8 BLOCK 14 TO THE SOUTHEASTERLY CORNER OF LOT 8; THENCE IN A SOUTHWESTERLY DIRECTION ALONG THE SOUTHERLY BORDER LINE OF LOT 8 BLOCK 14, 10 FEET TO THE PLACE OF BEGINNING.

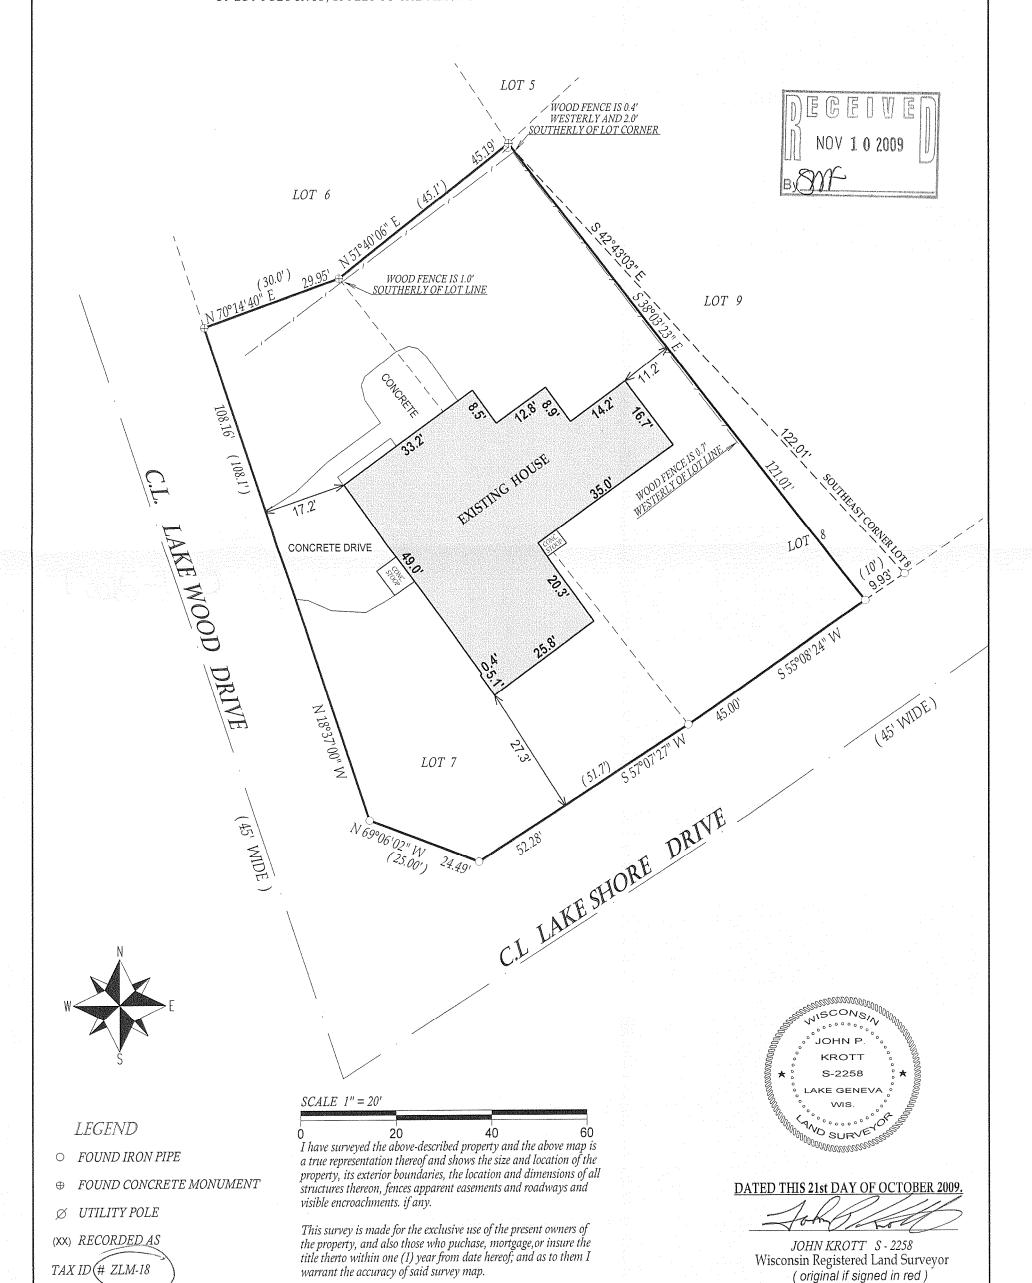

NOTE: BEARINGS REFRENCED TO PREVIOUS SURVEY RECORDS

007-2687