
HAROLD H. KOLB

REGISTERED PROFESSIONAL LAND SURVEYOR LAKE GENEVA, WISCONSIN

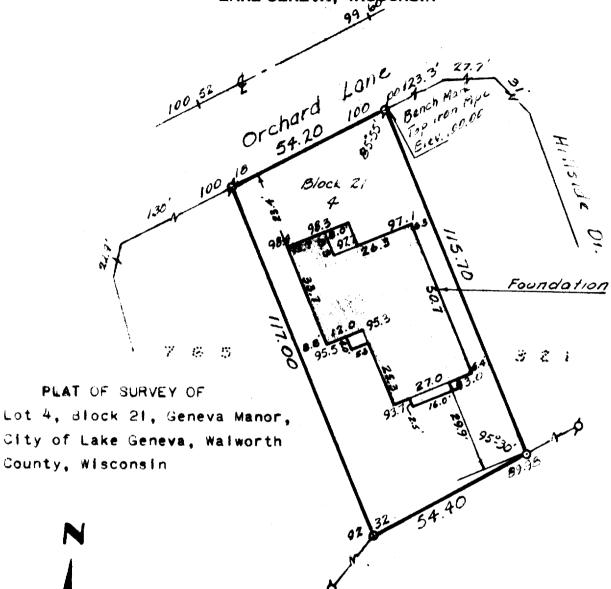

LEGEND

P - IRON PIPE FOUND

O - IRON PIPE PLACED

• - CONCRETE MONUMENT

X - SPIKE

scale ["= 30"

HAROLD H AKE GENEVA. I, HAROLD H. KOLB, DO HEREBY CERTIFY THAT I HAVE SURVEYED THE PROPERTY HEREON DESCRIBED ACCORDING TO THE OFFICIAL RECORDS, AND THAT THE PLAT HEREON IS A CORRECT REPRESENTATION OF THE LOT LINES.

WISCONSIN REGISTERED LAND SURVEYOR, S-187

DATE Feb. 26, 1968

July 9, 1968 Foundation location

7-269