


# PLAT OF SURVEY

Lot 5 in The Highlands of Lake Geneva, being a Subdivision of part of the Northwest Quarter of the Southwest Quarter of Section 31, Township 2 North, Range 18 East of the Fourth Principal Meridian according to the Plat thereof recorded June 30, 2006 as Document Number 681124, in Walworth County, Wisconsin.


## HIGHLAND WAY

(60' ROW)

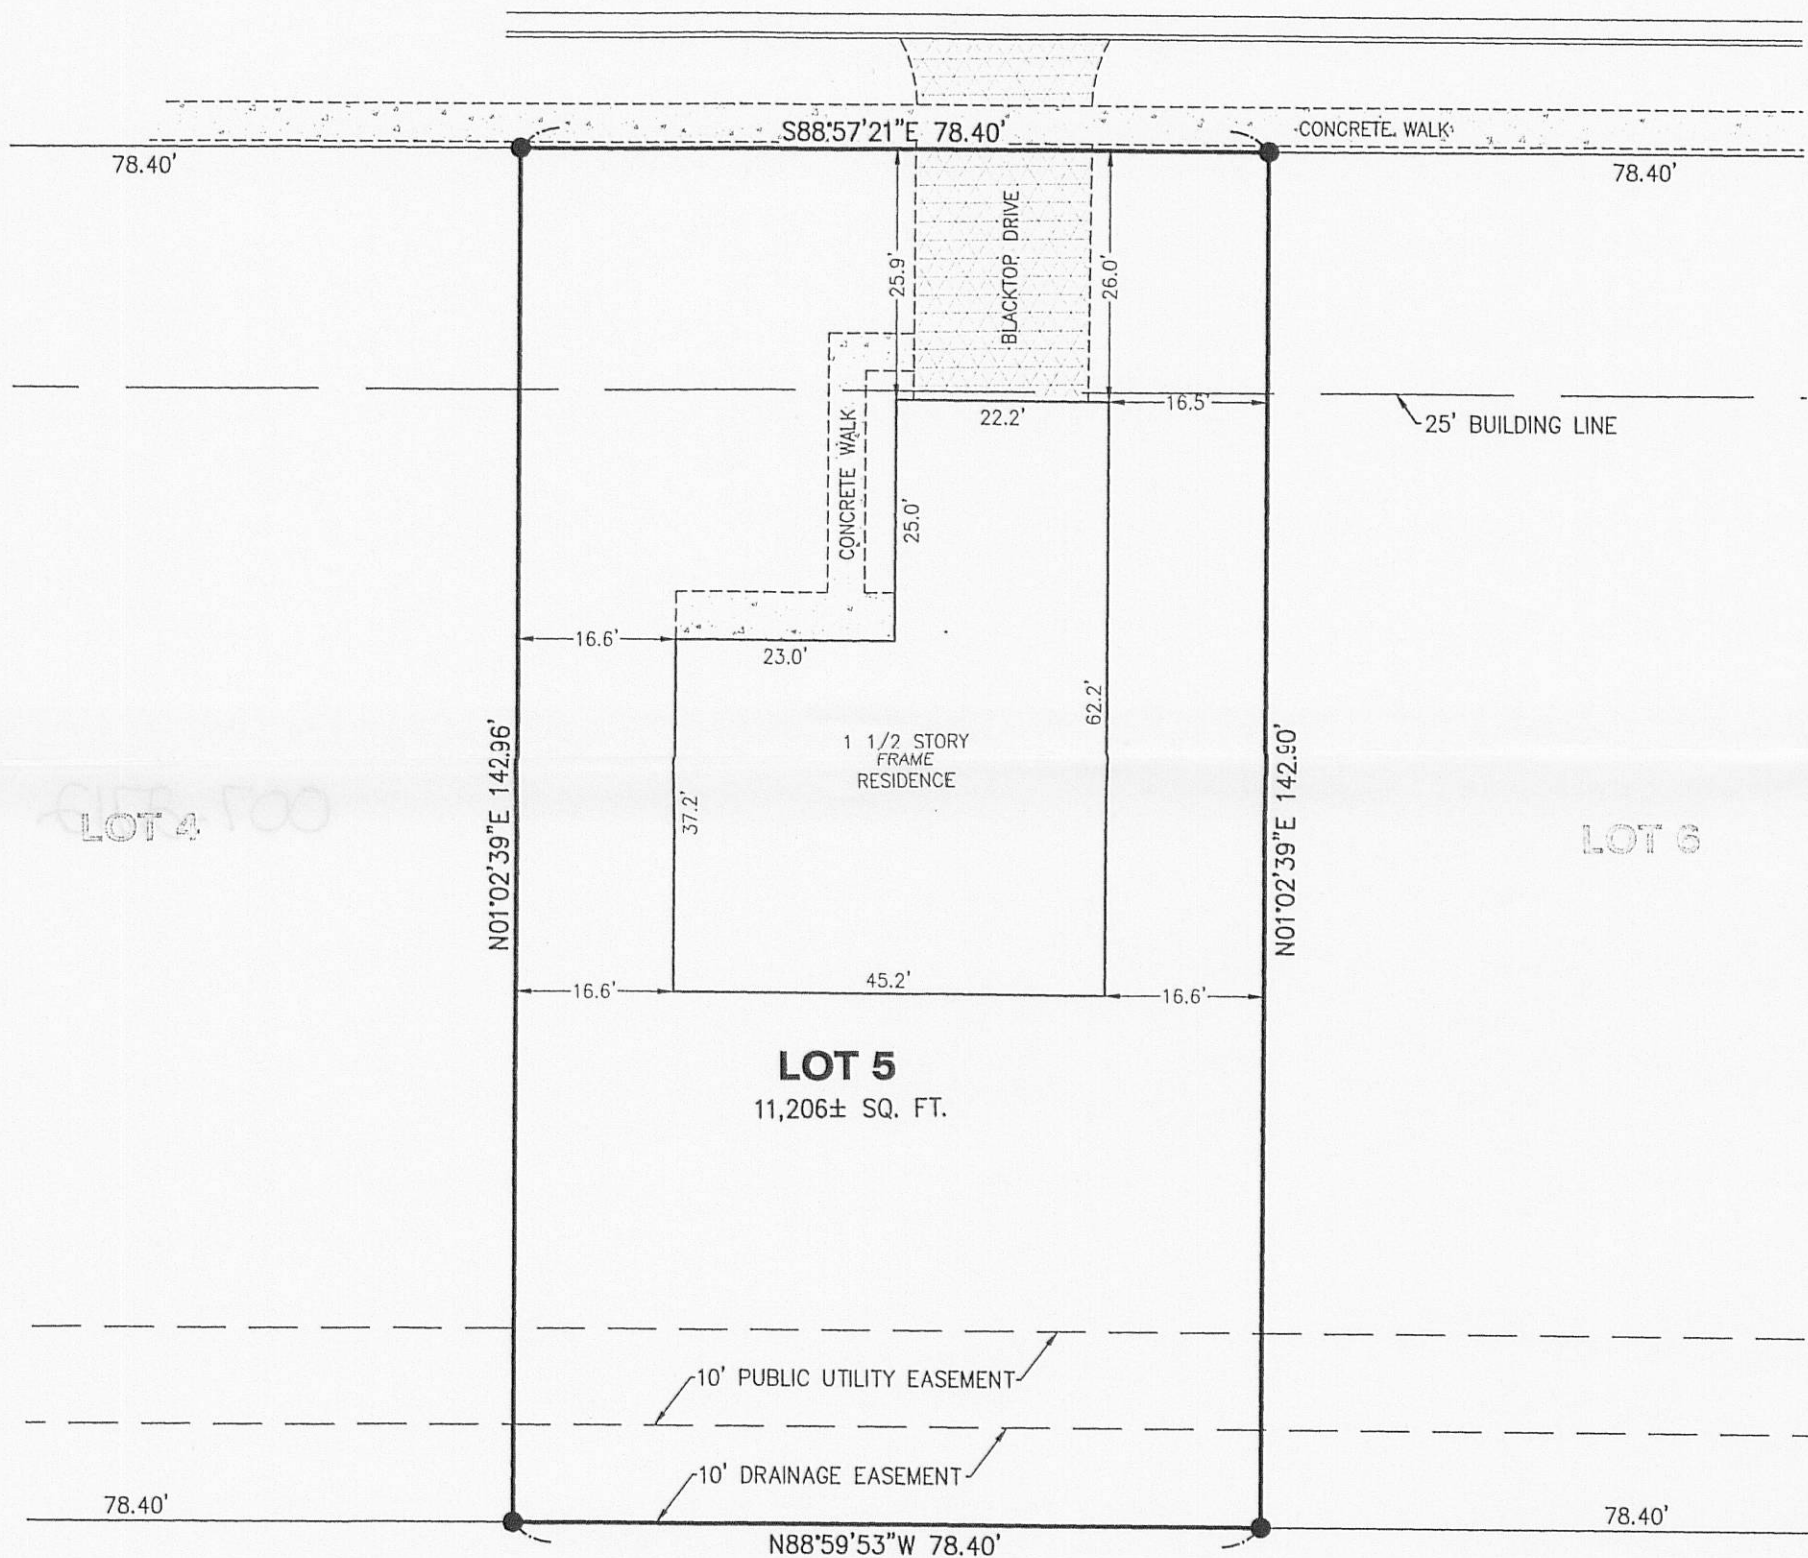

LEGEND	
● FOUND IRON BAR	⊙ SET IRON BAR
⊗ FOUND NAIL	⊗ SET NAIL
⊕ FOUND SPIKE	⊕ SET SPIKE
✱ FOUND CROSS	⊗ SET CROSS
○ FOUND IRON PIPE	⊠ FOUND MONUMENT

CLIENT: ARMOR HOMES  
DRAWN BY: CDH CHECKED BY: WJV  
SCALE: 1" = 20' SEC. 31 T. 02 R. 18 E.  
BASIS OF BEARING: RECORD SUBDIVISION  
P.I.N.:  
JOB NO.: 070017-005 I.D. LSS  
FIELDWORK COMP.: 09/06/07 BK. PG.  
ALL DISTANCES SHOWN IN FEET AND DECIMAL REF:  
PARTS THEREOF CORRECTED TO 68° F.

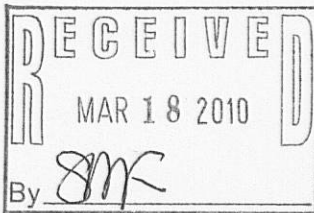

NOTE: Only those Building Line Restrictions or Easements shown on a Recorded Subdivision Plat are shown hereon unless the description ordered to be surveyed contains a proper description of the required building lines or easements.  
\* No distance should be assumed by scaling.  
\* No underground improvements have been located unless shown and noted.  
\* No representation as to ownership, use, or possession should be hereon implied.  
\* This Survey and Plat of Survey are void without original embossed or colored seal and signature affixed.  
Compare your description and site markings with this plat and AT ONCE report any discrepancies which you may find.

STATE OF ILLINOIS )  
COUNTY OF McHENRY ) S.S.

In my professional opinion and based on my observations, I hereby certify that the above described property has been surveyed under my direction and that the above map is a true representation thereof and shows the size and location of all visible structures, and dimensions of all principle buildings thereon, boundary fences, apparent easements, roadways, and visible encroachments, if any. This survey is made for the use of the present owners of the property, and also those who purchase, mortgage, or guarantee the title thereto within one year from the date hereof.

Dated at Woodstock,  
McHenry County, Illinois 09/07 A.D., 20 07.

VANDERSTAPPEN SURVEYING & ENGINEERING, INC.  
Design Firm No. 184-002792

By:   
Wisconsin Registered Land Surveyor No. S1777