

PREPARED FOR
DOROTHY HIGGINS GERBER
SHOREWEST REALTORS
623 MAIN ST.
LAKE GENEVA WI. 53147


PLAT OF SURVEY

-OF-

KROTT SURVEYING INC.

N3705 WILLOW BEND LANE
LAKE GENEVA WI. 53147
PHONE # (262)248-3697
FAX # (262)249-0639

LOT 11 OF GARRISON GLEN SUBDIVISION, LOCATED IN
SOUTHWEST 1/4 AND THE SOUTHEAST 1/4'S OF THE
NORTHEAST 1/4 OF SECTION 1, TOWN 1 NORTH, RANGE
17 EAST, CITY OF LAKE GENEVA, WALWORTH COUNTY,
WISCONSIN.

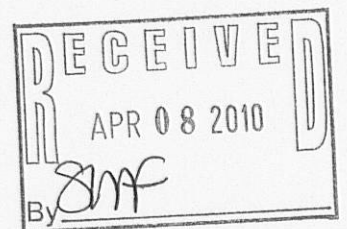

LEGEND

- FOUND IRON PIPE
- FOUND IRON BAR
- ⓔ ELECTRICAL PEDESTAL

NOTE: BEARINGS REFERENCED TO THE RECORD PLAT AND THE WEST LINE OF LOT 11 WAS ASSUMED TO BEAR N 1°25'20" W

I have surveyed the above-described property and the above map is a true representation thereof and shows the size and location of the property, its exterior boundaries, the location and dimensions of all structures thereon, fences apparent easements and roadways and visible encroachments, if any.

(XX) RECORDED AS
TAX ID # ZGAR00011
JOB # 10-015

This survey is made for the exclusive use of the present owners of the property, and also those who purchase, mortgage, or insure the title thereto within one (1) year from date hereof; and as to them I warrant the accuracy of said survey map.

JOHN KROTT S - 2258
Wisconsin Registered Land Surveyor
(original if signed in red)

DATED THIS 28th DAY OF JANUARY 2010.

007-2729