


Iron Pipe at
Wisconsin and
Broad Streets

HAROLD H. KOLB

REGISTERED PROFESSIONAL LAND SURVEYOR
LAKE GENEVA, WISCONSIN

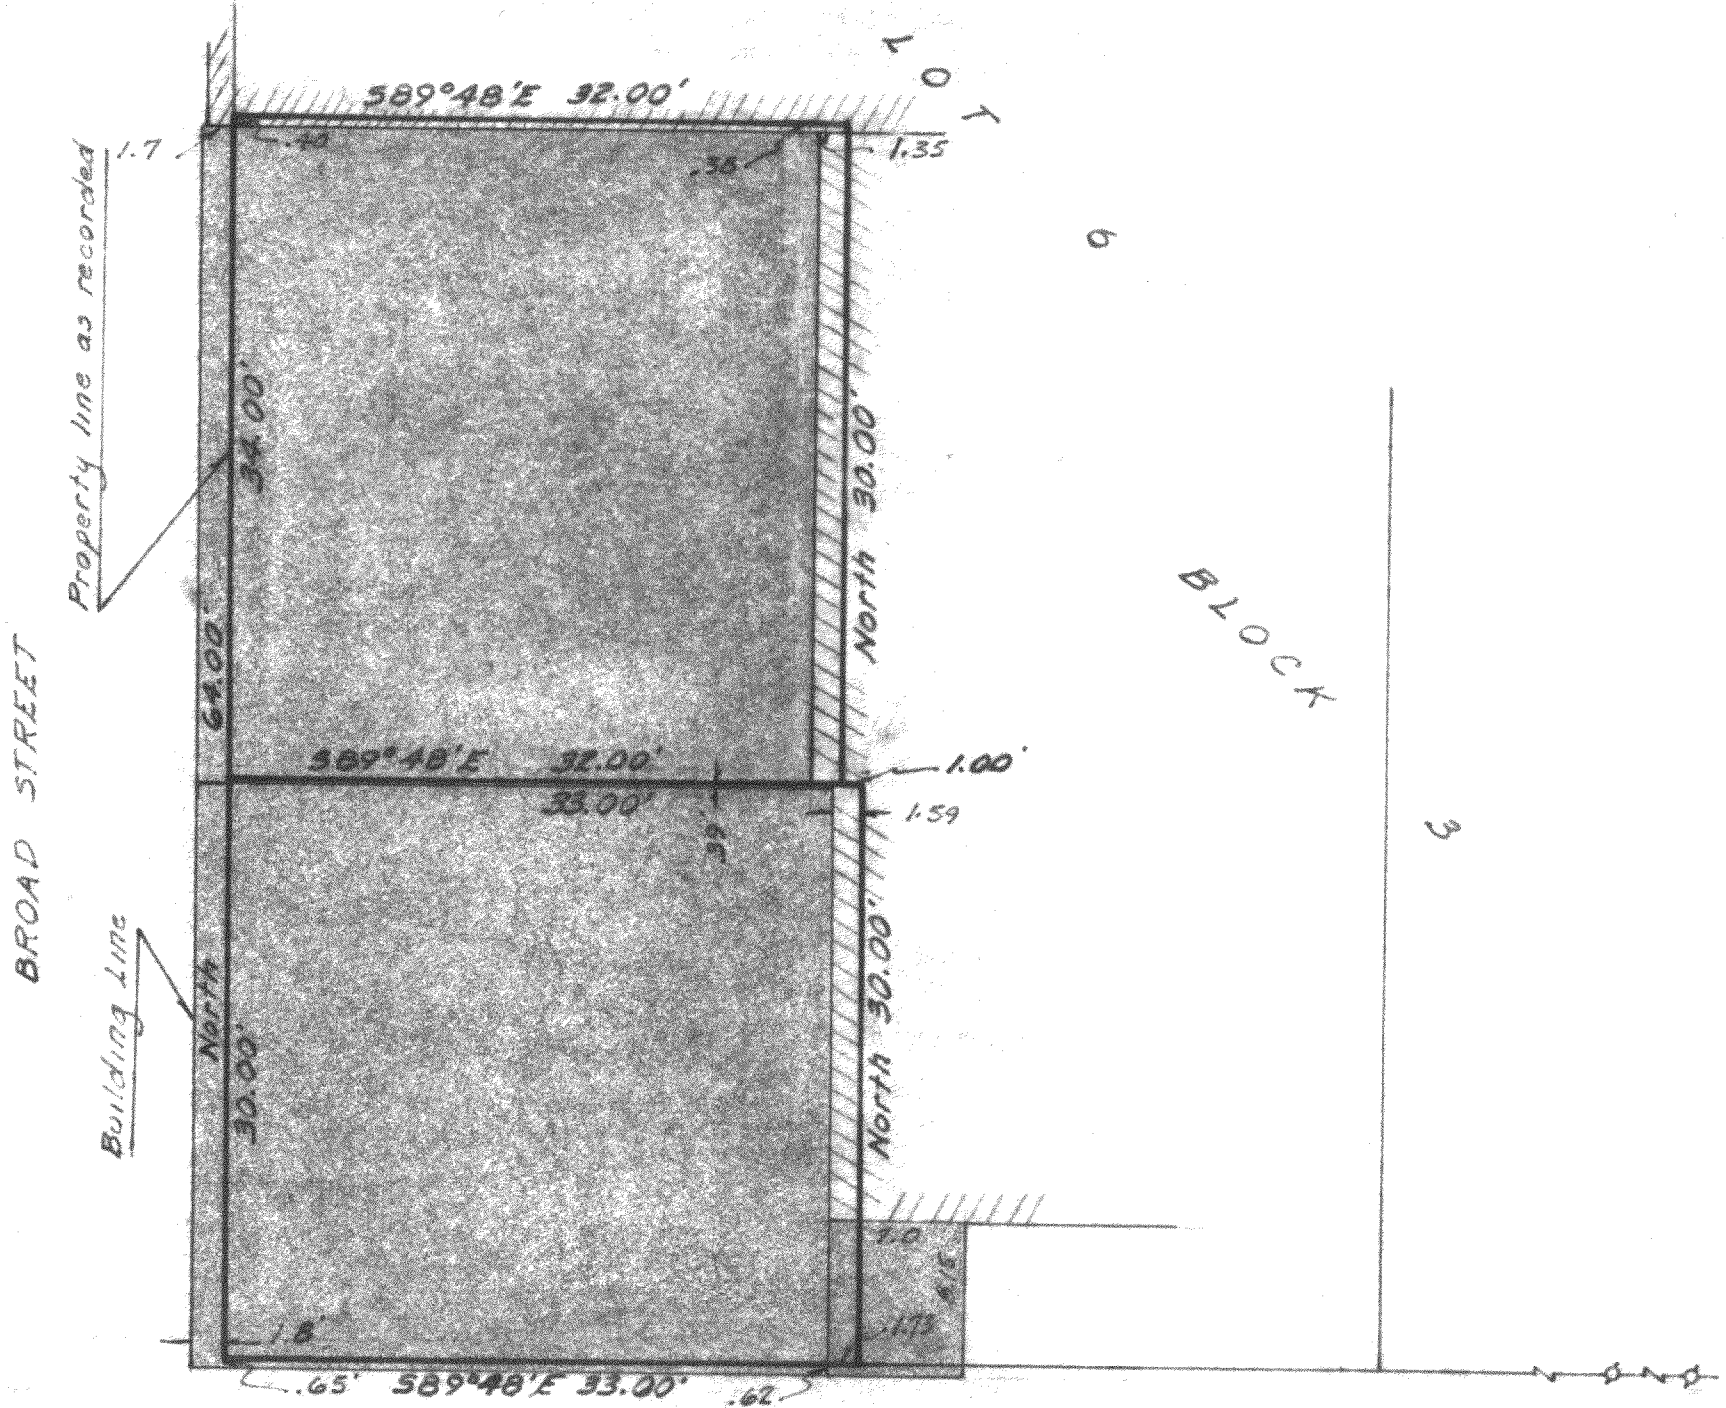

PLAT OF SURVEY OF

Part of Lot 6, Block ³⁰~~3~~, Original Plat of the Village,
now City, of Lake Geneva, Walworth County, Wisconsin,
as described in Vol. 425 of Land Contracts, page 339,
and as monumented.

N



SCALE 1"=10'

LEGEND

- - IRON PIPE FOUND
- - IRON PIPE PLACED
- - CONCRETE MONUMENT
- x - CROSS IN CONCRETE

||||| - ADJACENT BUILDINGS

I, HAROLD H. KOLB, DO HEREBY CERTIFY THAT I HAVE
SURVEYED THE PROPERTY HEREON DESCRIBED ACCORDING
TO THE OFFICIAL RECORDS, AND THAT THE PLAT HEREON
IS A CORRECT REPRESENTATION OF THE LOT LINES.

Harold H. Kolb

HAROLD H. KOLB

WISCONSIN REGISTERED LAND SURVEYOR, S-187

DATE April 9, 1968

0/2 324

GD-9 (RVD)

7-273