
PREPARED FOR: HOMESTEAD REALTY 520 BROAD STREET LAKE GENEVA, WI 53147

PLAT OF SURVEY

- OF -

LOT 9, BLOCK 27, LAKE GENEVA CRAWFORD MANUFACTURING COMPANY ADDITION TO THE CITY OF LAKE GENEVA, WALWORTH COUNTY, WISCONSIN.

PATHFINDER SURVEYING INC. (formerly) J.K. SURVEYING INC. P.O BOX 322 LAKE GENEVA, WI. 53147 262-248-8303

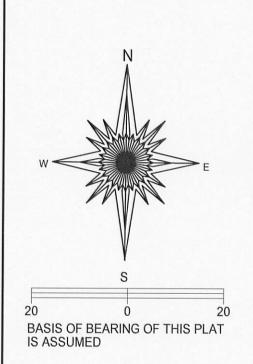

found iron pipe found bent iron pipe 2.6' south and 0.6' west 2.8' south and 1.3' west 175.34' (176.00') S 89°54'57" E 13.91 89.43' 36.58 OAK LANE (PLATTED AS 40' WIDE) 8.00' RESIDENCE 29.51 GARAGE 8.00' 14.20' 10.35 20.19' 26.35' **GRAVEL** 174.78' (176.00') N 89°54'31" E 0



()= recorded as

□ = found iron bar

= found iron pipe

= set iron pipe

= set iron bar

SCALE 1" = 20'


JOB # 10-76

TAX ID # ZGC 00177

"I hereby certify that I have surveyed the above described property and that the above map is a true representation of its exterior boundary and shows the size and location of all visible structures, apparent easements and encroachments if any."

This survey is made for the present owners of the property, and those who purchase, mortgage, or guarantee the title thereto, within one year from the date hereof.

DATED THIS 7TH DAY OF JUNE, 2010.

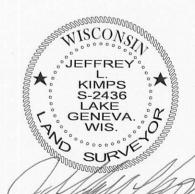

JEFFREY L KIMPS 5 - 2436 Wisconsin Registered Land Surveyor (original if signed in red)

007 2758