


PREPARED FOR:
BERWYN BRADEN
716 WISCONSIN ST.
LAKE GENEVA, WI
53147



RIPARIAN RIGHTS SURVEY
OF

LOT 1 AND OUTLOT 1 OF CERTIFIED SURVEY MAP NO. 1341
LOCATED IN THE SOUTHEAST 1/4 OF SECTION 35, TOWN 2
NORTH, RANGE 17 EAST, CITY OF LAKE GENEVA, WALWORTH
COUNTY, WISCONSIN.

KROTT SURVEYING INC.
N3705 WILLOW BEND LANE
LAKE GENEVA WI. 53147
PHONE # (262)248-3697
FAX # (262)249-0639

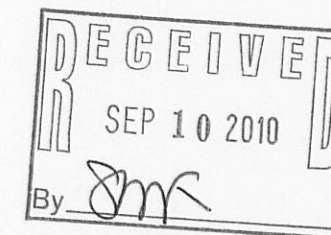


POINT REFERRED TO IN VOLUME 631 PAGE 582 OF
RECORDS IN THE REGISTER OF DEEDS OFFICE
WALWORTH COUNTY WISCONSIN, BEING 26.5 FEET
N 54°27' W OF THE NORTHEASTLY CORNER
OF LOT 1, BLOCK 19, LAKE GENEVA MANOR

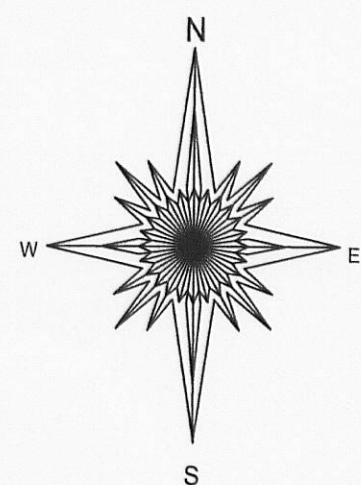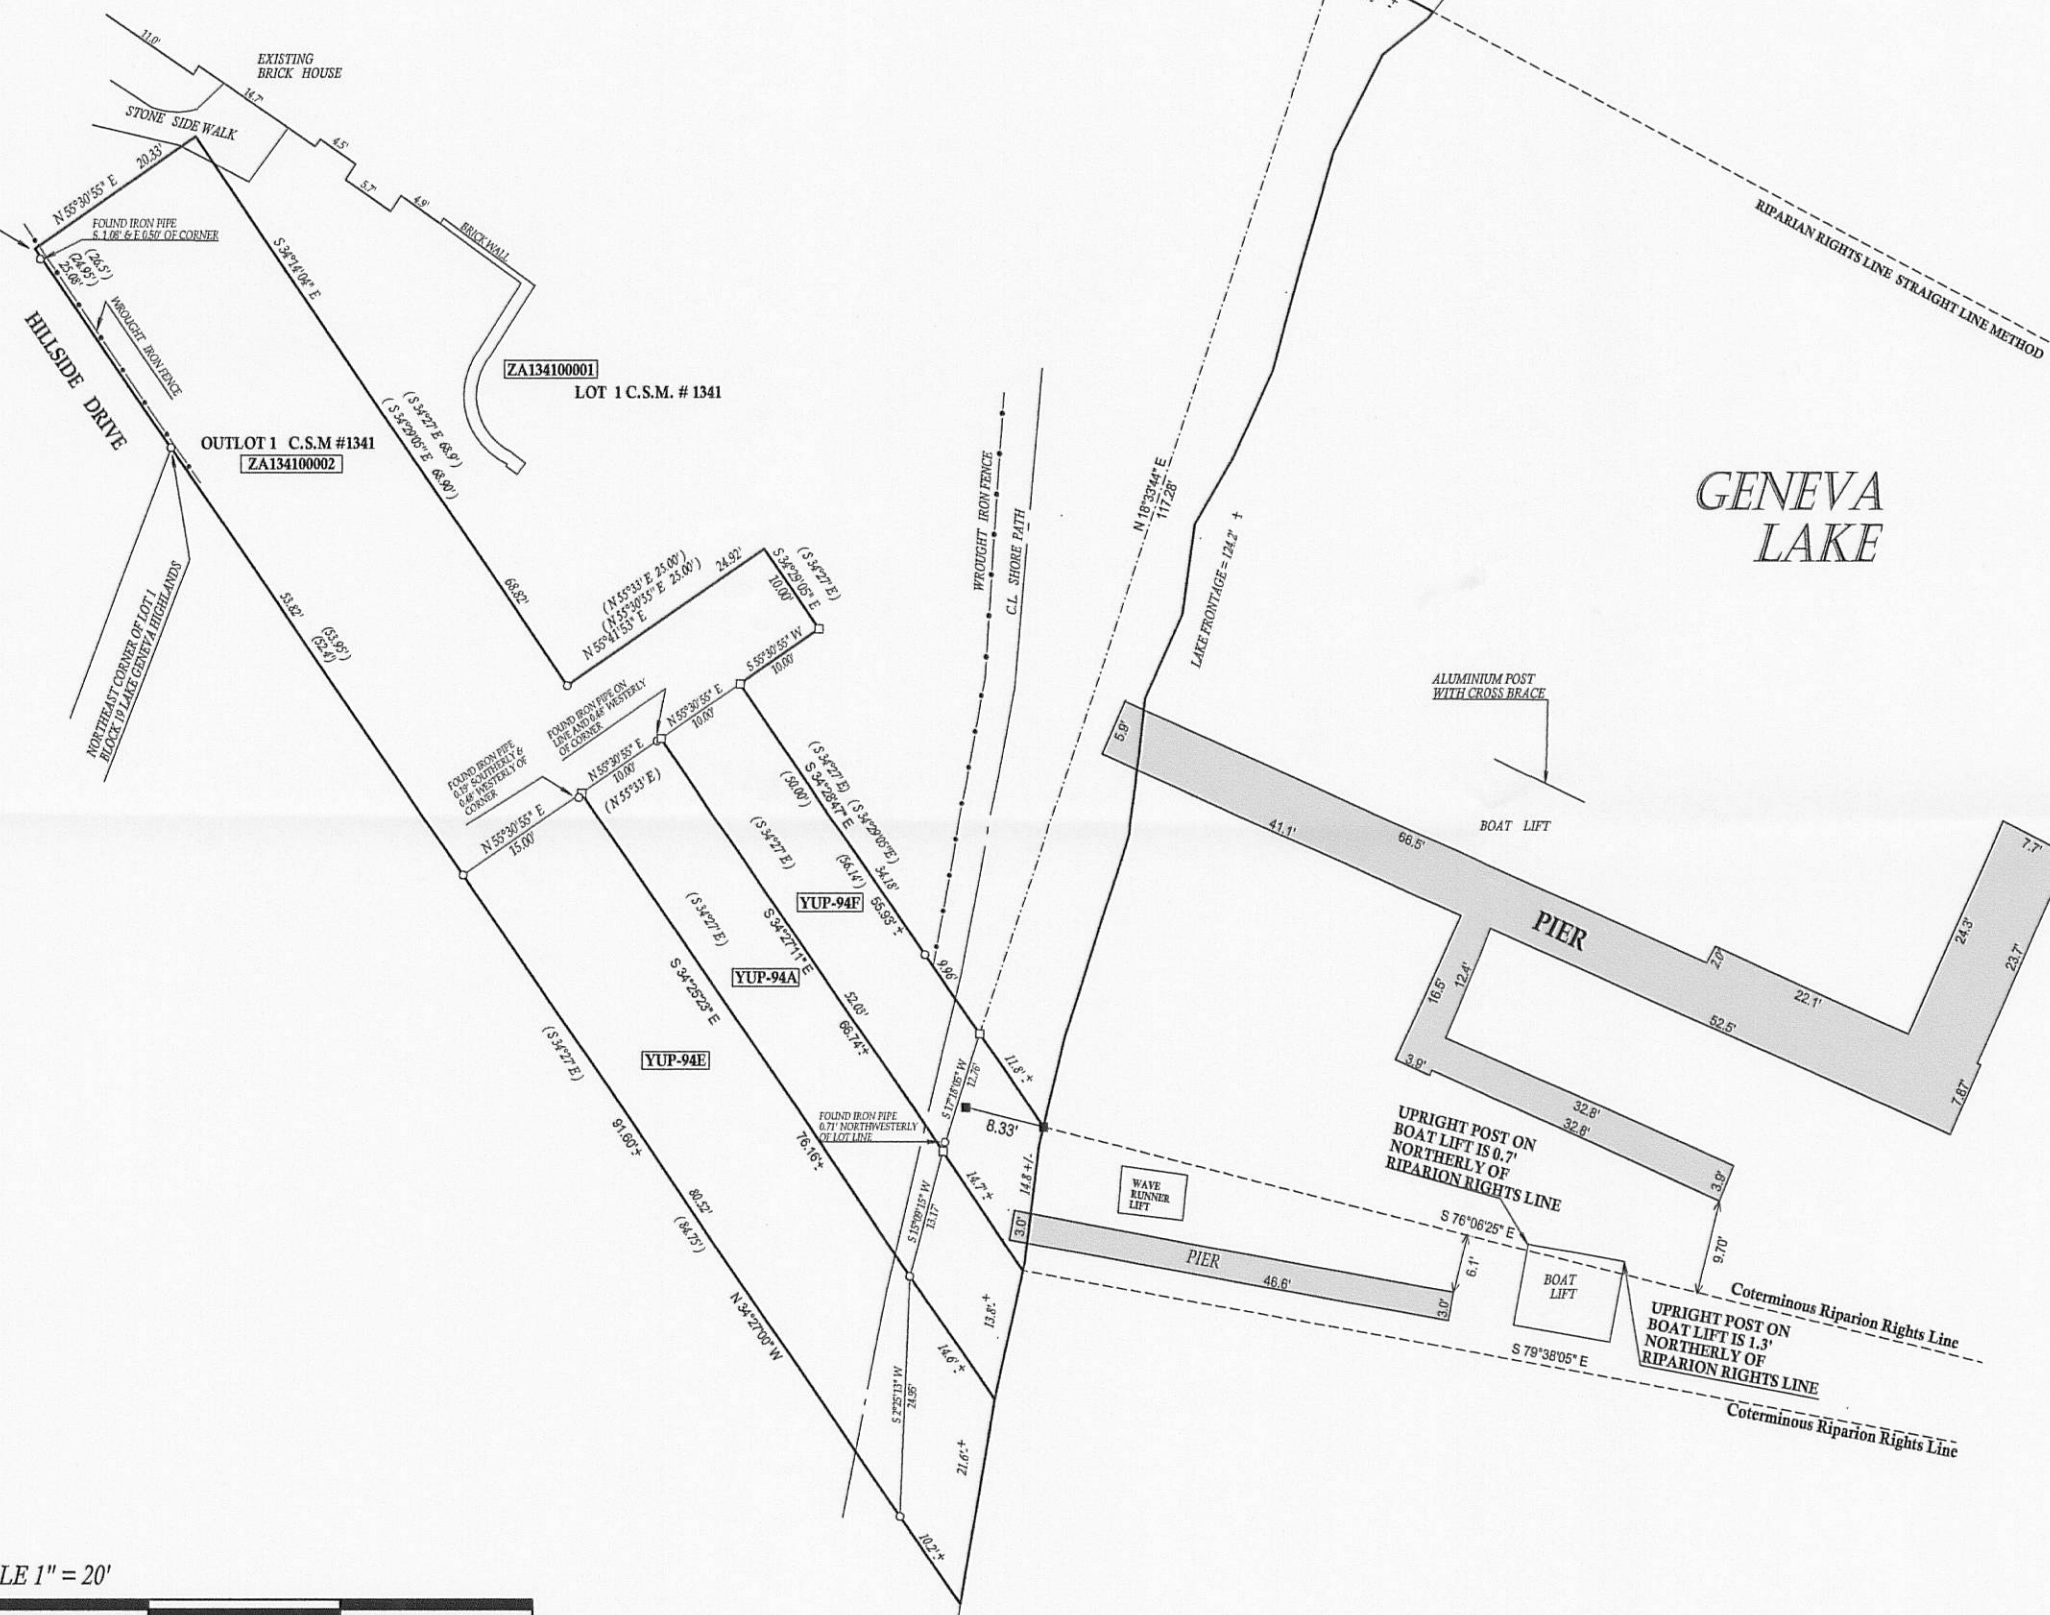

LEGEND

- () = recorded as
- = set iron bar
- = found iron bar
- = found iron pipe
- = set iron pipe

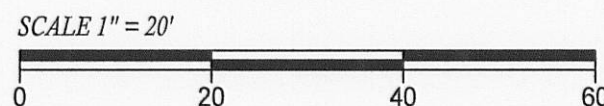


NOTE RIPARIAN RIGHTS LINES DETERMINED
BY USING ORDINARY HIGH WATER MARK
LINE AS ESTABLISHED BY WISCONSIN D.N.R.

JOB # 04-374 2010

TAX KEY # ZA134100001

BEARINGS ARE REFERENCED TO CERTIFIED SURVEY MAP NO. 1341

DATED THIS 19th, DAY OF JUNE, 2008

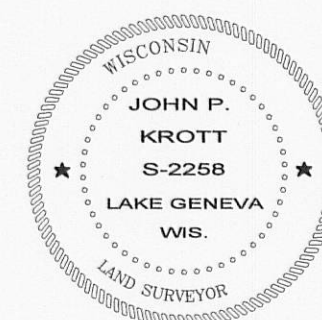

DATE OF LAST REVISION 7 / 27 / 2010

John P. Krott
JOHN KROTT S - 2258
Wisconsin Registered Land Surveyor
(original if signed in red)