

PREPARED FOR
CHRIS KAYSER
KEEFE REAL ESTATE
751 GENEVA PARKWAY
LAKE GENEVA WI. 53147



PLAT OF SURVEY

- OF -


UNIT 3 OF THE FIRST ADDENDUM TO THE COTTAGES OF LAKE GENEVA
HILLS, A CONDOMINIUM LOCATED IN THE SW 1/4 OF THE SE 1/4 OF
SECTION 26, TOWN 2 NORTH, RANGE 17 EAST, CITY OF LAKE GENEVA,
COUNTY OF WALWORTH AND STATE OF WISCONSIN.

KROTT SURVEYING INC.

N3705 WILLOW BEND LANE
LAKE GENEVA WI. 53147
PHONE # (262)248-3697
FAX # (262)249-0639

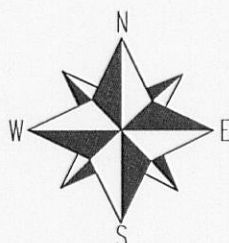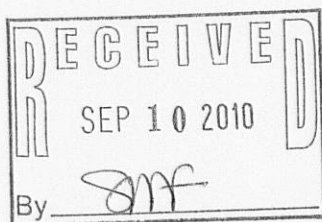


SCALE 1" = 20'

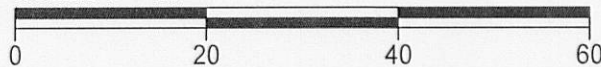

NOTE : BEARINGS REFRENCED TO THE RECORD PLAT

I have surveyed the above-described property and the above map is a true representation thereof and shows the size and location of the property, its exterior boundaries, the location and dimensions of all structures thereon, fences apparent easements and roadways and visible encroachments. if any.

This survey is made for the exclusive use of the present owners of the property, and also those who purchase, mortgage, or insure the title therto within one (1) year from date hereof; and as to them I warrant the accuracy of said survey map.

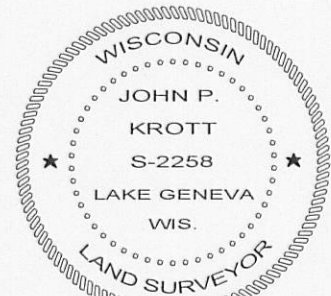

DATED THIS 23rd DAY OF JULY 2010.

John P. Krott

JOHN KROTT S - 2258
Wisconsin Registered Land Surveyor
(original if signed in red)

LEGEND

□ FOUND IRON BAR

Ⓢ UTILITY PEDISTALS

Ⓣ TRANSFORMER

(XX) RECORDED AS

TAX ID # ZCOT00003

JOB # 10-122

007-27105-9190