

PREPARED FOR:  
JAMES IZARD  
W3126 GENEVA BAY, DR.  
LAKE GENEVA, WI 53147

PLAT OF SURVEY

KROTT SURVEYING, INC.  
N3705 WILLOW BEND LANE  
LAKE GENEVA, WI 53147  
(262)- 248-3697

-OF-

LOT 14, BLOCK 1, GENEVA BAY ESTATES, TOWN 1 NORTH, RANGE 17 EAST,  
AND THE CITY OF LAKE GENEVA, WALWORTH COUNTY, WISCONSIN





- ( ) = recorded as
- = found iron bar
- = found iron pipe
- = set iron pipe
- = set iron bar
- ⊕ = found concrete monument

BEARINGS REFERENCED TO THE RECORD PLAT  
OF GENEVA BAY ESTATES

I have surveyed the above-described property and the above map is  
a true representation thereof and shows the size and location of the  
property, its exterior boundaries, the location and dimensions of all  
structures thereon, fences apparent easements and roadways and  
visible encroachments, if any.

This survey is made for the exclusive use of the present owners of  
the property, and also those who purchase, mortgage, or insure the  
title thereto within one (1) year from date hereof; and as to them I  
warrant the accuracy of said survey map.

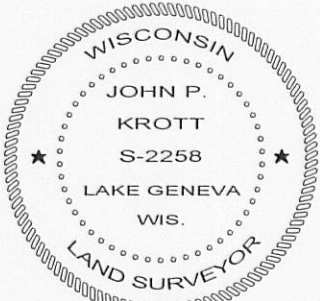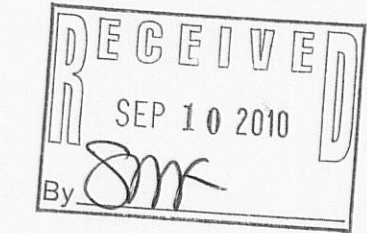

DATED THIS 2nd, DAY OF SEPTEMBER, 2010

*John P. Krott*  
JOHN KROTT S - 2258  
Wisconsin Registered Land Surveyor  
( original if signed in red )

JOB # 02-664PA

7GB-14 JGBE-14A

007-2768